

CODED

Pontotoc
B 68
12-67

MISSISSIPPI
BOARD OF WATER COMMISSIONERS
416 North State Street
Jackson, Mississippi 39201

WATER WELL DRILLERS LOG

12-6-67 19 Lamer Wicks Pontotoc
date well completed firm name county well located

LANDOWNER:

A-B-Mc DONALD
ECHO, MISS-RT-1-
(mailing address)

description of formations encountered

	from	to
GREY LOAM	0	18
LIMESTONE	18	44
BLUE SHALE	44	120
ROCK + SAND	120	180

WELL LOCATION:

sec. 36 T 8 S R 2 E
miles of (distance) (direction) (nearest town)


WELL PURPOSE:

(home, irrigation, municipal, industrial)

WELL COMPLETION DATA:

- (1) diameter (inches) 4
- (2) total depth (feet) 180
- (3) static water level (feet) 68 below above top of ground.
- (4) casing STEEL, 34 (material), (depth), 4" if telescope see back. (size)
- (5) screen (length) (depth to top) (size) (material)
- (6) pump 3/4 (HP), 7 (yield gpm) ELECTRIC (type power)
- (7) electric log (yes or no) (organization running log)
- (8) how well bottom plugged

CODED

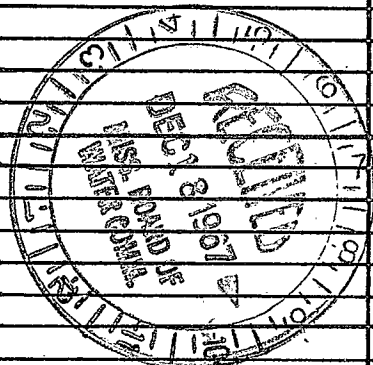

DRILLERS REMARKS:

