

**CODED**

**CODED**

PONTOTOC

B-69

3-68

MISSISSIPPI  
 BOARD OF WATER COMMISSIONERS  
 416 North State Street  
 Jackson, Mississippi 39201

WATER WELL DRILLERS LOG

3-8-68 19  
date well completed

LANN: AT WILDER PONTOTOC  
firm name

county well located

LANDOWNER:

Lewis HARRIS

THAYTON, MISS  
(mailing address)

WELL LOCATION:

sec. 17 T. 9 N. R. 2 E  
 S. of PONTOTOC  
7 miles W of PONTOTOC  
 (distance) (direction) (nearest town)

WELL PURPOSE: HOME  
 (home, irrigation, municipal, industrial)

WELL COMPLETION DATA:


- (1) diameter (inches) 4
- (2) total depth (feet) 320
- (3) static water level (feet) 69 below above top of ground.
- (4) casing STEEL 84  
 (material) (depth)  
4" if telescope see back.  
 (size)
- (5) screen \_\_\_\_\_  
 (length) (depth to top)  
 \_\_\_\_\_  
 (size) (material)
- (6) pump 1 5  
 (HP) (yield gpm)  
ELECTRIC  
 (type power)
- (7) electric log NO  
 (yes or no)  
 \_\_\_\_\_  
 (organization running log)
- (8) how well bottom plugged \_\_\_\_\_

description of formations encountered

from to

KEY ROCKSAND	0	20
BLUE SHALE	20	40
BLUE SHALE (ROCKY)	40	65
BLUE SHALE	65	260
ROCK & SAND	260	320


**CODED**

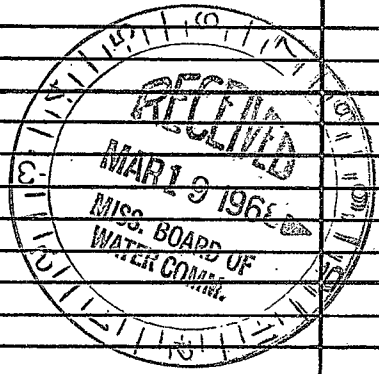

DRILLERS REMARKS:

If well telescopes please sketch and show depths.

GROUND LEVEL

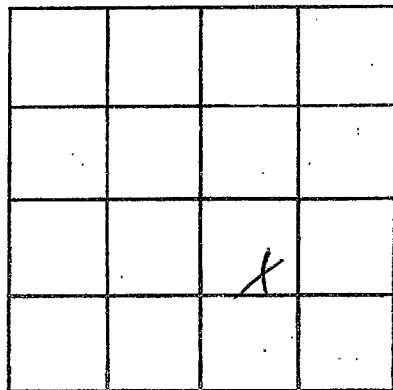

SECTION \_\_\_\_\_

Please indicate well location X.

ADDITIONAL INFORMATION

If more than one screen,  
show locations of each on sketch.