

**CODED**

**CODED**

MISSISSIPPI  
BOARD OF WATER COMMISSIONERS  
416 North State Street  
Jackson, Mississippi 39201

**WATER WELL DRILLERS LOG**

Pontotoc  
B-70  
3-68

3-15-68 19 LAMAR WILDER PONTOTOC  
date well completed firm name county well located

**LANDOWNER:**

H.B. BROWN

RT 3 Pontotoc  
(mailing address)

**WELL LOCATION:**

sec 33 T 9 N R 2 E  
S W  
4 miles W of Pontotoc  
(distance) (direction) (nearest town)

**WELL PURPOSE:**

(home, irrigation, municipal, industrial)

**WELL COMPLETION DATA:**

- (1) diameter (inches) 4
- (2) total depth (feet) 130
- (3) static water level (feet) 75 below above top of ground.
- (4) casing STEEL, 130  
(material) (depth)

           if telescope see back.  
(size)

- (5) screen                        
(length) (depth to top)

           (size)            (material)

- (6) pump 1/2 7  
(HP) (yield gpm)

ELECTRIC  
(type power)

- (7) electric log             
(yes or no)

            
(organization running log)

- (8) how well bottom plugged

**description of formations encountered**


from to

GRAY BUCKSHOT	0	25
BLUE SHALE	25	110
LIMESTONE (10' to 15')	110	120
LIMESTONE (SOLID)	120	135
LOCK & SAND	135	160
SOLID LOCK	160	200
LOCK & SAND	200	262

**NOTE -**

CUSTOMER INSISTED ON 130 FT-CASEINS. IN MY OPINION, CASEINS SHOULD HAVE BEEN SET AT 100 FT.

**CODED**

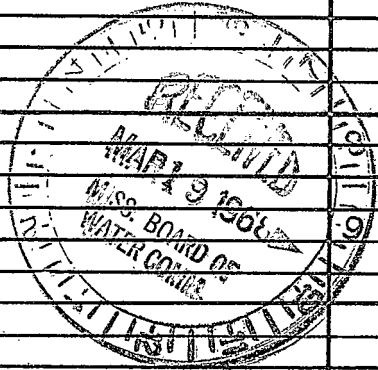

**DRILLERS REMARKS:**

If well telescopes please sketch and show depths.

GROUND LEVEL


SECTION \_\_\_\_\_

Please indicate well location X.

ADDITIONAL INFORMATION

If more than one screen, show locations of each on sketch.