

CODED

Pontotoc
 B-71
 6-5-68

MISSISSIPPI
 BOARD OF WATER COMMISSIONERS
 416 North State Street
 Jackson, Mississippi 39201

WATER WELL DRILLERS LOG

6-5 1968 Ed Clark Con. Pontotoc
 date well completed firm name county well located

LANDOWNER: Jimmy
 Yarnon
 Pontotoc St. 2
 (mailing address)


description of formations encountered	from to	
	ft	ft
Shale	0	35
Rock & Sand	35	75
Blue Mud	75	200
Rock & Sand	200	250

WELL LOCATION:
 sec. 18 T 9 R 2 E
 6 miles W of Pontotoc
 (distance) (direction) (nearest town)

WELL PURPOSE: Home
 (home, irrigation, municipal, industrial)

- WELL COMPLETION DATA:
- diameter (inches) 4"
 - total depth (feet) 250'
 - static water level (feet) 160' below top of ground.
 - casing Metal, 93'
 (material) (depth)
 4" if telescope see back.
 (size)
 - screen None
 (length) (depth to top)
 (size) (material)
 - pump 1 1/2 HP, 6
 (HP) (yield gpm)
 Electric
 (type power)
 - electric log no
 (yes or no)
 (organization running log)
 - how well bottom plugged no


CODED

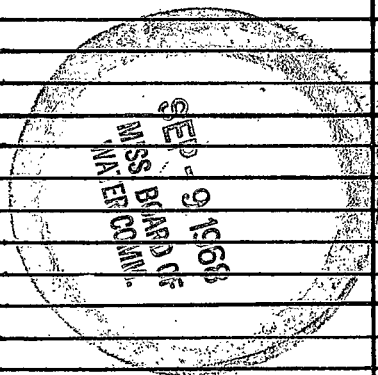

DRILLERS REMARKS:

If well telescopes please sketch and show depths.

GROUND LEVEL

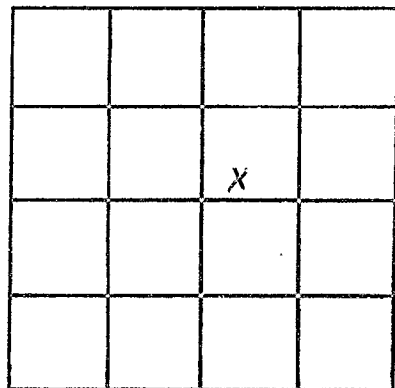

SECTION _____

Please indicate well location X.

ADDITIONAL INFORMATION

If more than one screen,
show locations of each on sketch.