

CODED

Pontotoc
B-72
6-24-68

MISSISSIPPI
 BOARD OF WATER COMMISSIONERS
 416 North State Street
 Jackson, Mississippi 39201

WATER WELL DRILLERS LOG

6-24 1968 Ed Clark, Con. Pontotoc
 date well completed firm name county well located

LANDOWNER:Walter Morrison

Pontotoc Rt - 5
 (mailing address)

WELL LOCATION:

sec. 7 T 9 S R. 2 E
7 miles W of Pontotoc
 (distance) (direction) (nearest town)

WELL PURPOSE: Home
 (home, irrigation, municipal, industrial)

WELL COMPLETION DATA:

- (1) diameter (inches) 4"
 (2) total depth (feet) 240'
 (3) static water level (feet) 60' below top of ground.
 (4) casing Metal, 35'
 (material) (depth)
4" if telescope see back.
 (size)
 (5) screen None
 (length) (depth to top)
 (size) (material)
 (6) pump 1 jet 16
 (HP) (yield gpm)
Electric
 (type power)
 (7) electric log NO
 (yes or no)
 (organization running log)
 (8) how well bottom plugged NO


description of formations encountered

from

to


<u>Gravel</u>	<u>0</u>	<u>35</u>
<u>Rock & Sand</u>	<u>35</u>	<u>75</u>
<u>Blue mud</u>	<u>75</u>	<u>190</u>
<u>Rock & Sand</u>	<u>190</u>	<u>240</u>

CODED

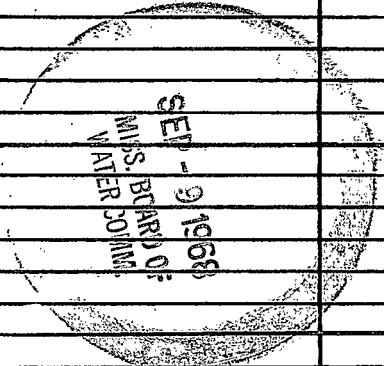**DRILLERS REMARKS:**

If well telescopes please sketch and show depths.

GROUND LEVEL

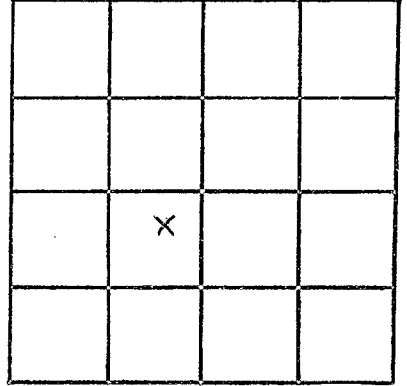

SECTION _____

Please indicate well location X.

ADDITIONAL INFORMATION

If more than one screen, show locations of each on sketch.