

CODED

Pontotoc
B-73
7-4-68

MISSISSIPPI
 BOARD OF WATER COMMISSIONERS
 416 North State Street
 Jackson, Mississippi 39201

WATER WELL DRILLERS LOG

7-4 1968 Ed Clark con. Pontotoc
 date well completed firm name county well located

LANDOWNER:

Lynn Moady
Pontotoc Rt-2
 (mailing address)

description of formations encountered

from to

| | | |
|------------------------|------------|------------|
| <u>Jumbo</u> | <u>0</u> | <u>45</u> |
| <u>Rock & Sand</u> | <u>45</u> | <u>85</u> |
| <u>Blue mud</u> | <u>85</u> | <u>206</u> |
| <u>Rock & Sand</u> | <u>206</u> | <u>286</u> |

WELL LOCATION:

sec. 7 T 9 N R 2 E
6 miles W of Pontotoc
 (distance) (direction) (nearest town)


WELL PURPOSE:

Home
 (home, irrigation, municipal, industrial)

WELL COMPLETION DATA:


- (1) diameter (inches) 4"
- (2) total depth (feet) 286'
- (3) static water level (feet) 60' below top of ground.
- (4) casing Metal, 126'
 (material) (depth)
4" if telescope see back.
 (size)
- (5) screen None
 (length) (depth to top)
 (size) (material)
- (6) pump 1/2 Sh., 9
 (HP) (yield gpm)
Electric
 (type power)
- (7) electric log no
 (yes or no)
 (organization running log)
- (8) how well bottom plugged no

CODED

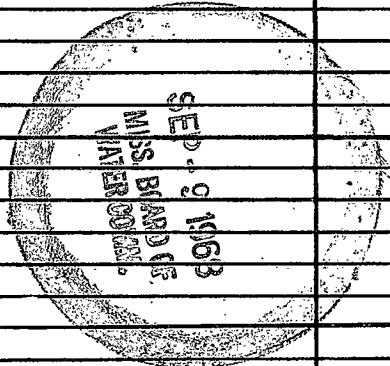**DRILLERS REMARKS:**

If well telescopes please sketch and show depths.

GROUND LEVEL

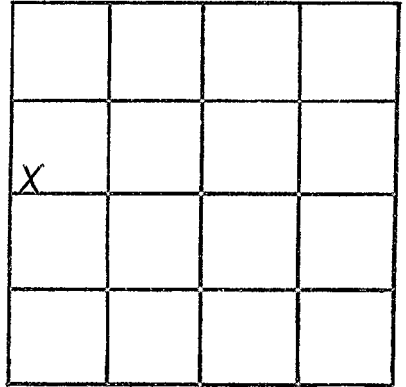

SECTION _____

Please indicate well location X.

ADDITIONAL INFORMATION

If more than one screen, show locations of each on sketch.