

Pontotoc
 B-74
 5-2-69

MISSISSIPPI
 BOARD OF WATER COMMISSIONERS
 416 North State Street
 Jackson, Mississippi 39201

CODED

WATER WELL DRILLERS LOG

5-2 19 W. Clark Bros. Pontotoc
 date well completed firm name county well located

LANDOWNER:
W. W. Honey
Pontotoc - MS
 (mailing address)

description of formations encountered	from	to
<u>Shale</u>	<u>0</u>	<u>20</u>
<u>Loam & Sand</u>	<u>20</u>	<u>80</u>
<u>Blue mud</u>	<u>80</u>	<u>180</u>
<u>Rock & Sand</u>	<u>180</u>	<u>200</u>

WELL LOCATION:
 sec. 10 T. 9 N. R. 2 E.
A-10 miles NW of Pontotoc
 (distance) (direction) (nearest town)

WELL PURPOSE: Home
 (home, irrigation, municipal, industrial)

- WELL COMPLETION DATA:
- (1) diameter (inches) 4"
 - (2) total depth (feet) 200'
 - (3) static water level (feet) 45' below top of ground.
 - (4) casing Metal 80'
 (material) (depth)
4" if telescope see back.
 (size)
 - (5) screen None
 (length) (depth to top)
 (size) (material)
 - (6) pump 1/2 Sub 8
 (HP) (yield gpm)
Electric
 (type power)
 - (7) electric log no
 (yes or no)
 (organization running log)
 - (8) how well bottom plugged no

CODED


MAY 2 1969

MISS. BD. OF WATER COMMISSIONERS

DRILLERS REMARKS:

If well telescopes please sketch and show depths.

GROUND LEVEL

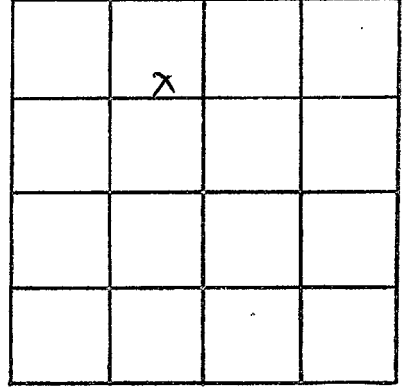

SECTION 10

Please indicate well location X.

ADDITIONAL INFORMATION

If more than one screen, show locations of each on sketch.