

Pontotoc
 B-75
 6-13-71

MISSISSIPPI
 BOARD OF WATER COMMISSIONERS
 416 North State Street
 Jackson, Mississippi 39201

WATER WELL DRILLERS LOG

6-13 1971 Clark Bros Driller
 date well completed firm name

CODED
 county well located

LANDOWNER:
 Doug Jones
 Earl Thomas
 (mailing address)

description of formations encountered	from	to
shales	0	30
Rock & Sand	30	90
blue mud	70	80
Rock & Sand	50	200

WELL LOCATION:
 39 sec 8 T 2 E
 2 85 miles SW of Earl
 (distance) (direction) (nearest town)

WELL PURPOSE: Home
 (home, irrigation, municipal, industrial)

- WELL COMPLETION DATA:
- (1) diameter (inches) 4"
 - (2) total depth (feet) 200'
 - (3) static water level (feet) 40' below top of ground.
 - (4) casing Metal 34" (material) (depth)
 4" (size) if telescope see back.
 - (5) screen None (length) (depth to top)
 (size) (material)
 - (6) pump 1/2 Sub 7 (HP) (yield: gpm)
 Electric (type power)
 - (7) electric log no (yes or no)
 (organization running log)
 - (8) how well bottom plugged no

CODED


SEP 13 1971

DRILLERS REMARKS:

MISS. BD. OF WATER COMMISSIONERS

If well telescopes please sketch and show depths.

GROUND LEVEL

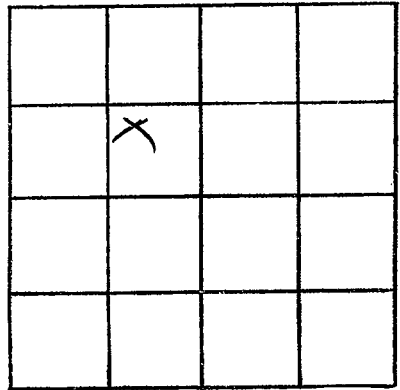

SECTION _____

Please indicate well location X.

ADDITIONAL INFORMATION

If more than one screen, show locations of each on sketch.