

PONTOTOC  
B-76  
8-7-71

MISSISSIPPI  
BOARD OF WATER COMMISSIONERS  
416 North State Street  
Jackson, Mississippi 39201

WATER WELL DRILLERS LOG

**CODED**

8-7-71  
date well completed

91 Clark Bros.  
firm name

Yazoo  
county well located

LANDOWNER:  
Buddy Parrish  
Care, Route 1  
(mailing address)

description of formations encountered	from	to
Shales	0	30
Rock & sand	30	60
Shales	60	200
Rock & sand	200	260

WELL LOCATION:  
sec. 10 T9 N R 2 E  
7 miles SW of Care  
(distance) (direction) (nearest town)

WELL PURPOSE: Home  
(home, irrigation, municipal, industrial)

- WELL COMPLETION DATA:
- (1) diameter (inches) 4"
  - (2) total depth (feet) 260'
  - (3) static water level (feet) 50' below top of ground.
  - (4) casing Metal, 84' (material) (depth)  
4" (size) if telescope see back.
  - (5) screen None (length) (depth to top)
  - (6) pump 1 1/2 HP, 6 (yield gpm)  
Electric (type power)
  - (7) electric log (yes or no)
  - (organization running log)
  - (8) how well bottom plugged AD

**CODED**


SEP 13 1971

MISS. Bd. OF  
WATER COMMISSIONERS

DRILLERS REMARKS:

If well telescopes please sketch and show depths.

GROUND LEVEL

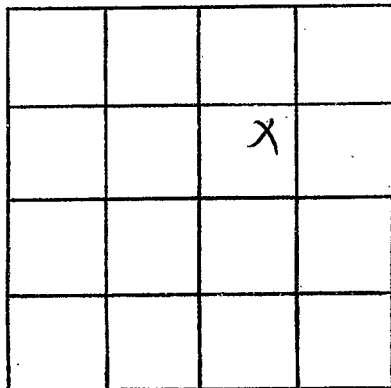

SECTION \_\_\_\_\_

Please indicate well location X.

ADDITIONAL INFORMATION

If more than one screen,  
show locations of each on sketch.