

Pontotoc
 B-78
 8-3-71

MISSISSIPPI
 BOARD OF WATER COMMISSIONERS
 416 North State Street
 Jackson, Mississippi 39201

CODED

WATER WELL DRILLERS LOG

Aug 3 1971 date well completed
 J.W. Webb & Sons firm name
 Pontotoc county well located

LANDOWNER: <u>Phillip Walls</u>	description of formations encountered	from	to
<u>Shafter, Miss</u> (mailing address)	<u>Soil</u>	<u>0</u>	<u>1</u>
WELL LOCATION:	<u>clay</u>	<u>1</u>	<u>28</u>
sec. <u>18</u> T <u>95</u> N R. <u>2</u> E	<u>sandy clay</u>	<u>58</u>	<u>74</u>
<u>2 1/2</u> miles <u>East</u> of <u>Shafter</u>	<u>Blue Rock</u>	<u>74</u>	<u>291</u>
(distance) (direction) (nearest town)	<u>Water Rock</u>	<u>291</u>	<u>293</u>
WELL PURPOSE:	<u>Water sand & Rocks</u>	<u>293</u>	<u>385</u>
(home, irrigation, municipal, industrial)	<u>Pipley sand</u>		
WELL COMPLETION DATA:			
(1) diameter (inches) <u>4"</u>			
(2) total depth (feet) <u>385</u>			
(3) static water level (feet) <u>79</u> below above top of ground.			
(4) casing <u>stal</u> , <u>94'</u>			
(material) (depth)			
<u>4"</u> if telescope see back.			
(size)			
(5) screen <u>0</u> , <u>0</u>			
(length) (depth to top)			
(size) (material)			
(6) pump <u>1-1/2</u> jet <u>6</u>			
(HP) (yield gpm)			
<u>Elec</u>			
(type power)			
(7) electric log (yes or no)			
(organization running log)			
(8) how well bottom plugged			
DRILLERS REMARKS:			


CODED

SEP 16 1971

MISS. Bd. OF WATER COMMISSIONERS

If well telescopes please sketch and show depths.

GROUND LEVEL

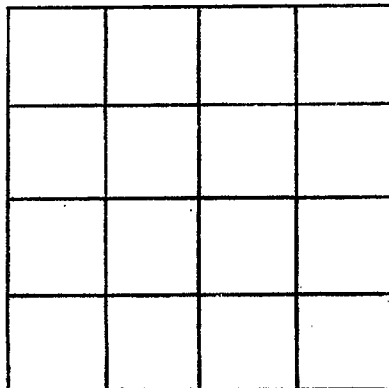

SECTION _____

Please indicate well location X.

ADDITIONAL INFORMATION

Multiple horizontal lines provided for writing additional information.

If more than one screen, show locations of each on sketch.