

Date: 1-28, 1964, Driller: L. CARLISLE County: UNION

B 80

(Name)

CODED

(1) Owner of Land: LEVI HUMPHRIES
 (Name)
ECRU MISS
 (Address)

(2) Location: 1/4, 1/4, Sec. 24 T8 R2
2 miles NW of ECRU
 (distance) (direction) (Nearest Town)

(3) Topography: X
 (Hilly) (Flat) (Level)

(4) Purpose of Well: DOMESTIC
 (Domestic Irrigation
 Municipal, Industrial, Other)

Description & Color of Materials - Sand, Clay, Red Clay, Shell, etc.	Thickness Feet	Depth Feet
RED CLAY	25	
ROCK	3	28
BLUE DIRT	48	76
WATER ROCK	2	78
" SAND	42	120

Information upon completion of well:

(1) Diameter: 4 inches.

(2) Total Depth: 130 feet.

(3) Water Level: 20 feet below top of ground.

(4) Cased to: 84, Size _____

(5) Screen: Size _____, Length _____


(6) Were any formations sealed against pollution?
 _____ yes, _____ no.

CODED

If YES depth of formation _____

Why _____

Drillers Remarks: _____

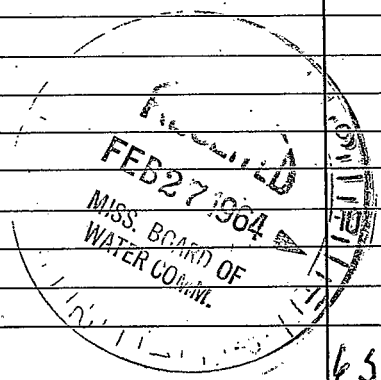

45 Well 1

(Use Back Side)

1758

1758
52

1810

1810