

Date: 9-2-65, 1965, Driller: Ralph Clark County Union
(Name)

B82

CODED

(1) Owner of Land: Jimmie Owens
(Name)
Pontotoc, Miss.
(Address)

(2) Location: 1/4, 1/4, Sec. 29 T. 9 R. 2
8 miles West, of Pontotoc
(distance) (direction) (Nearest Town)

(3) Topography: Flat
(Hilly) (Flat) (Level)

(4) Purpose of Well: Home Use
(Domestic Irrigation
Municipal, Industrial, Other)

Description & Color of Materials Sand, Clay, Red Clay, Shell, etc.	Thickness feet	Depth Feet
<u>Humus</u>	<u>30</u>	<u>30</u>
<u>Sand & Rock</u>	<u>50</u>	<u>80</u>
<u>Blue Mud</u>	<u>150</u>	<u>180</u>
<u>Rock & Sand</u>	<u>34</u>	<u>314</u>

Information upon completion of well:

(1) Diameter 4 inches.

(2) Total Depth 314 feet.


(3) Water Level 40 feet below top of ground.

(4) Cased to 84 ft, Size _____, Length _____.

(5) Screen: Size _____, Length _____.

(6) Were any formations sealed against pollution?
_____ yes, _____ no.

CODED

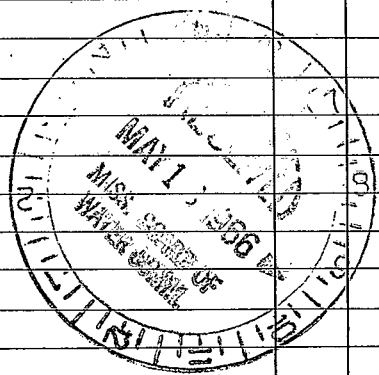

If YES depth of formation _____

Why _____

Drillers Remarks: _____

Clark Bros

(Use Back Side)

Well No.

6302

6302