

B 83

12-16-65

WATER WELL DRILLERS LOG

CODED

Date: 12, 16, 1965, Driller: Ralph Clark County Union
 (Name)


- (1) Owner of Land: Bobby Tatum
 (Name)
Pontotoc, Miss
 (Address)
- (2) Location: 1/4, 1/4, Sec. 32, 33T. 2R. 2,
9 miles West, of Pontotoc
 (distance) (direction) (Nearest Town)
- (3) Topography: Flat
 (Hilly) (Flat) (Level)
- (4) Purpose of Well: Home Use
 (Domestic Irrigation
 Municipal, Industrial, Other)

Description & Color of Materials Sand, Clay, Red Clay, Shell, etc.	Thick- ness Feet	Depth Feet
<u>Mud</u>	<u>40</u>	<u>40</u>
<u>Rock + sand</u>	<u>40</u>	<u>40</u>
<u>Blue mud</u>	<u>150</u>	<u>150</u>
<u>Rock + sand</u>	<u>30</u>	<u>30</u>

Information upon completion of well:

- (1) Diameter 4 inches.
- (2) Total Depth 260 feet.
- (3) Water Level 60 feet below top of ground.
- (4) Cased to 86 ft. Size _____, Length _____
- (5) Screen: Size _____, Length _____.
- (6) Were any formations sealed against pollution?
 _____ yes, _____ no.

CODED

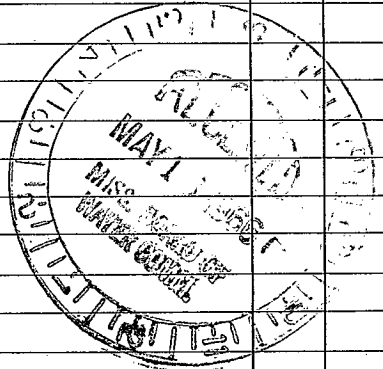

If YES depth of formation _____
 Why _____
 Drillers Remarks: _____

Clark Bros.

(Use Back Side)

Well No.

1950

1951

1952