

PONTOTOC MISSISSIPPI BOARD OF WATER COMMISSIONERS

B 84

1-20-66

WATER WELL DRILLERS LOG

CODED

Date: 7, 20, 19, Driller: Ralph Clark County Union
(Name)

(1) Owner of Land: ^{white} May McWize
(Name)
Pontotoc, Miss
(Address)

(2) Location: 1/4, 1/4, Sec. 12 T 9 R 2
3 miles South of Ecure
(distance) (direction) (Nearest Town)

(3) Topography: Flat
(Hilly) (Flat) (Level)

(4) Purpose of Well: Home Use
(Domestic Irrigation, Municipal, Industrial, Other)

Description & Color of Materials Sand, Clay, Red Clay, Shell, etc.	Thick- ness Feet	Depth Feet
<u>Gumbo</u>	<u>20</u>	<u>20</u>
<u>Rock + Sand</u>	<u>30</u>	<u>30</u>
<u>Blue mud</u>	<u>80</u>	<u>80</u>
<u>Rock + Sand</u>	<u>70</u>	<u>70</u>

Information upon completion of well:

(1) Diameter 4 inches.

(2) Total Depth 200 feet.

(3) Water Level 45 feet below top of ground.

(4) Cased to 63 ft. Size _____

(5) Screen: Size _____, Length _____


(6) Were any formations sealed against pollution?
_____ yes, _____ no.

CODED

If YES depth of formation _____

Why _____

Drillers Remarks: _____

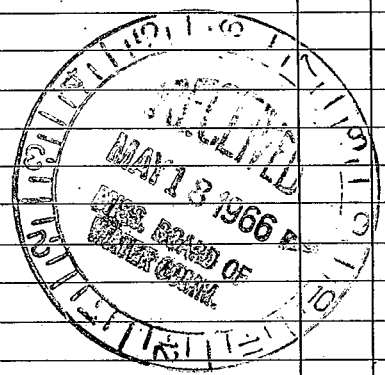

Clark Bros.

(Use Back Side)

Well No.

0103

0103

12