

PONTOTOC
B 86
11-25-71

MISSISSIPPI
 BOARD OF WATER COMMISSIONERS
 416 North State Street
 Jackson, Mississippi 39201

WATER WELL DRILLERS LOG

11-25-1971 date well completed
 Leeper Drilling Co firm name
 Pontotoc county well located

LANDOWNER:
 Frank Stubblefield
 Rt 2 - Pontotoc
 (mailing address)

| description of formations encountered | from | to |
|---------------------------------------|------|-----|
| Red Clay + Red sand | 0 | 40 |
| Blue clay | 40 | 84 |
| Blue clay + Chalk | 84 | 335 |
| Sand | 335 | 335 |

WELL LOCATION:
 sec. 23 T 9 S R 2 E
 4 miles NW of Pontotoc
 (distance) (direction) (nearest town)

WELL PURPOSE: home
 (home, irrigation, municipal, industrial)

- WELL COMPLETION DATA:
- (1) diameter (inches) 4
 - (2) total depth (feet) 335
 - (3) static water level (feet) 80 below top of ground.
 - (4) casing steel, 84 (material) (depth)
 4 (size) if telescope see back.
 - (5) screen open (length) (depth to top)
 (size) (material)
 - (6) pump 3/4 (HP) 7 (yield gpm)
 Elect (type power)
 - (7) electric log no (yes or no)

(organization running log)
 (8) how well bottom plugged open


DRILLERS REMARKS:

JAN 10 1972

MISS. ST. OF
 WATER COMMISSIONERS

If well telescopes please sketch and show depths.

GROUND LEVEL

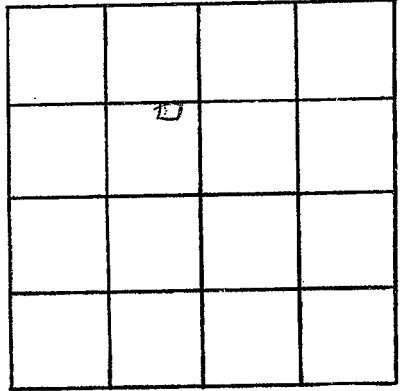

SECTION 23

Please indicate well location X.

ADDITIONAL INFORMATION

If more than one screen,
show locations of each on sketch.