

PONTOTOC

B 88

4-22-72

MISSISSIPPI BOARD OF WATER COMMISSIONERS 416 North State Street Jackson, Mississippi 39201

WATER WELL DRILLERS LOG

4-22-1972 date well completed

Leepul Drilling Co. - Pontotoc firm name county well located

LANDOWNER:

Cy Graham Rt-Pontotoc (mailing address)

description of formations encountered

from to

Red Clay + Rock 0 40
Rock + Blue Clay 40 120
Blue Clay 120 300
Blue Clay + Chalk 300 500
Chalk + Sand 500 645

WELL LOCATION:

sec 34 T 9 N R 2 E 4 miles S of Thaxton (distance) (direction) (nearest town)

WELL PURPOSE: home (home, irrigation, municipal, industrial)

WELL COMPLETION DATA:


- (1) diameter (inches) 4
(2) total depth (feet) 645
(3) static water level (feet) 120 below top of ground.
(4) casing steel, 84 (material) (depth)
(5) screen none (length) (depth to top)
(6) pump 3/4 (HP) 10 (yield gpm)
(7) electric log no (yes or no)
(8) how well bottom plugged open

1972

DRILLERS REMARKS:

If well telescopes please sketch and show depths.

GROUND LEVEL

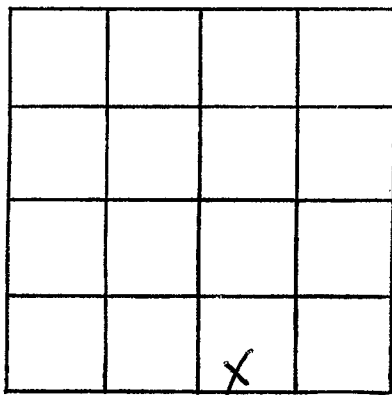

SECTION 34

Please indicate well location X.

ADDITIONAL INFORMATION

If more than one screen, show locations of each on sketch.