

PONTOTOC
B89
5-8-72

MISSISSIPPI
BOARD OF WATER COMMISSIONERS
416 North State Street
Jackson, Mississippi 39201

WATER WELL DRILLERS LOG

5-8-1972
date well completed

Leeped Drilling Co - Pontotoc
firm name


county well located

LANDOWNER:	description of formations encountered	from	to
<p>Jahmy Sellers Rt 1 Pontotoc (mailing address)</p>	<p>Flint sand & Gravel - Blue Clay Blue Clay & Chalk Rock Sand -</p>	<p>0 40 84 200</p>	<p>40 84 200 285</p>
<p>WELL LOCATION: sec. <u>6</u> T. <u>9</u> N. R. <u>2</u> E <u>5</u> W <u>7</u> miles <u>NW</u> of <u>Pontotoc</u> (distance) (direction) (nearest town)</p>			
<p>WELL PURPOSE: <u>home</u> (home, irrigation, municipal, industrial)</p>			
<p>WELL COMPLETION DATA:</p>			
<p>(1) diameter (inches) <u>4</u></p>			
<p>(2) total depth (feet) <u>285</u></p>			
<p>(3) static water level (feet) <u>80</u> below above top of ground.</p>			
<p>(4) casing <u>steel</u>, <u>84</u> (material) (depth)</p>			
<p>_____ If telescope see back. (size)</p>			
<p>(5) screen <u>none</u> (length) (depth to top)</p>			
<p>_____ (size) _____ (material)</p>			
<p>(6) pump <u>3/4</u> <u>10</u> (HP) (yield gpm)</p>			
<p><u>Elect</u> (type power)</p>			
<p>(7) electric log <u>no</u> (yes or no)</p>			
<p>_____ (organization running log)</p>			
<p>(8) how well bottom plugged <u>open</u></p>			
<p>DRILLERS REMARKS:</p>			

72 1972

If well telescopes please sketch and show depths.

GROUND LEVEL

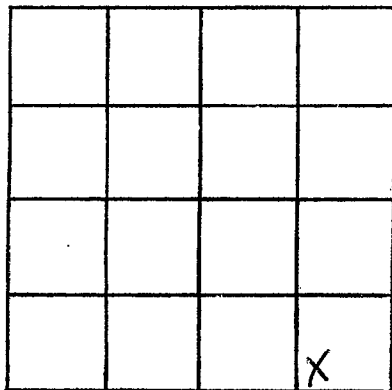

SECTION 6

Please indicate well location X.

ADDITIONAL INFORMATION

A series of horizontal lines for writing additional information.

If more than one screen, show locations of each on sketch.