

PONTOTOC  
B92  
9-14-72

MISSISSIPPI  
BOARD OF WATER COMMISSIONERS  
416 North State Street  
Jackson, Mississippi 39201

WATER WELL DRILLERS LOG

**CODED**

9-14-72 19 Ed Clark Pontotoc  
date well completed firm name county well located

LANDOWNER:

Ricky Parker  
Pontotoc, MS  
(mailing address)

description of formations encountered

from to

<u>Shales</u>	<u>0</u>	<u>35</u>
<u>Red Clay</u>	<u>35</u>	<u>70</u>
<u>Loam &amp; Sand</u>	<u>70</u>	<u>140</u>
<u>Blue Sand</u>	<u>140</u>	<u>220</u>
<u>Red Clay</u>	<u>220</u>	<u>350</u>
<u>Red &amp; Sand</u>	<u>350</u>	<u>350</u>

WELL LOCATION:

sec 34 T 8 R 2  
12 miles W of Law  
(distance) (direction) (nearest town)

WELL PURPOSE:

Home  
(home, irrigation, municipal, industrial)

WELL COMPLETION DATA:

- (1) diameter (inches) 4"
- (2) total depth (feet) 330'
- (3) static water level (feet) 45' below above top of ground.
- (4) casing Metals, 32'  
(material) (depth)  
4"  
(size) If telescope see back.
- (5) screen None  
(length) (depth to top)  
(size) (material)
- (6) pump 1 1/2 5  
(HP) (yield gpm)  
Electric  
(type power)
- (7) electric log no  
(yes or no)  
(organization running log)
- (8) how well bottom plugged no

**CODED**


SEP 20 1972

DRILLERS REMARKS:

MISS. B.O.W.C.  
WATER COMMISSIONERS

If well telescopes please sketch and show depths.

GROUND LEVEL

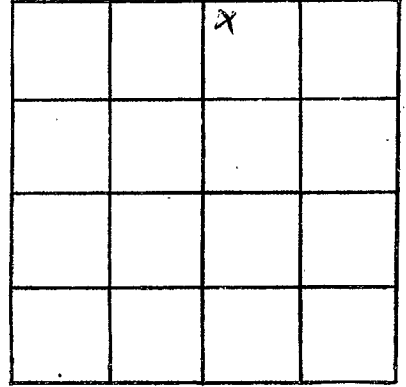

SECTION \_\_\_\_\_

Please indicate well location X.

ADDITIONAL INFORMATION

If more than one screen,  
show locations of each on sketch.