

PONTOTOC
B93
7-7-72

MISSISSIPPI
BOARD OF WATER COMMISSIONERS
416 North State Street
Jackson, Mississippi 39201

WATER WELL DRILLERS LOG

CODED

July 7 1972 Ed Clark Pontotoc
Date well completed firm name county well located

LANDOWNER:

Charlie Graham

description of formations encountered

from

to

Pontotoc Route 1
(mailing address)

Sand	0	30
Red clay	30	70
Blue mud	70	160
Rock & sand	160	220
Blue mud	220	280
Rock & sand	280	308

WELL LOCATION:

sec. 21 T⁸S R. 2 E
3 miles N.W. of Pontotoc
(distance) (direction) (nearest town)

WELL PURPOSE:

None
(home, irrigation, municipal, industrial)

WELL COMPLETION DATA:

- (1) diameter (inches) 4"
- (2) total depth (feet) 308'
- (3) static water level (feet) 30' below top of ground.
- (4) casing metal 82'
(material) (depth)
4" If telescope see back.
(size)
- (5) screen None
(length) (depth to top)
(size) (material)
- (6) pump (HP) (yield gpm)
(type power)
- (7) electric log No
(yes or no)
(organization running log)
- (8) how well bottom plugged No


CODED

DEC 4 1972

DRILLERS REMARKS:

If well telescopes please
sketch and show depths.

GROUND LEVEL

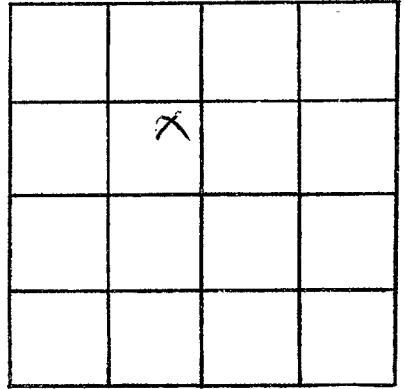

SECTION _____

Please indicate well location X.

ADDITIONAL INFORMATION

If more than one screen,
show locations of each on sketch.