

PONTOTOC
 B94
 9-28-72

MISSISSIPPI
 BOARD OF WATER COMMISSIONERS
 416 North State Street
 Jackson, Mississippi 39201

CODED

WATER WELL DRILLERS LOG

Sept 28 1972 Ed Clark
 date well completed firm name county well located Pontotoc

LANDOWNER:
 Toone Stepp
 Rt-4
 (mailing address)

description of formations encountered	from	to
Shales	0	20
Clay	20	60
Blue mud	60	170
Rock sand, water	170	330

WELL LOCATION:
 sec 27 T 3 S R 2 E
 1 miles E of Human
 (distance) (direction) (nearest town)

WELL PURPOSE:
 Home
 (home, irrigation, municipal, industrial)

- WELL COMPLETION DATA:
- (1) diameter (inches) 4"
 - (2) total depth (feet) 330'
 - (3) static water level (feet) 30' below top of ground.
 - (4) casing Metal 34' (material) (depth)
 4" (size) if telescope see back.
 - (5) screen None (length) (depth to top)
 - (6) pump (HP) (yield gpm)
 Electric (type power)
 - (7) electric log NO (yes or no)
 (organization running log)
 - (8) how well bottom plugged

CODED


DEC 4 1972

MISS. BD. OF WATER COMMISSIONERS

DRILLERS REMARKS:

If well telescopes please sketch and show depths.

GROUND LEVEL

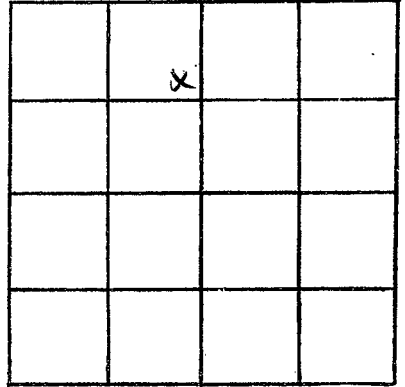

SECTION _____

Please indicate well location X.

ADDITIONAL INFORMATION

If more than one screen,
show locations of each on sketch.