

PONTOTOC  
 B 96  
 Guess?  
 11-68

MISSISSIPPI  
 BOARD OF WATER COMMISSIONERS  
 416 North State Street  
 Jackson, Mississippi 39201

**CODED**

WATER WELL DRILLERS LOG

*Wynn Gassler*

*Pontotoc*

date well completed 19          firm name          county well located         

LANDOWNER: *Wynn Gassler*  
*at 2 Pontotoc*  
 (mailing address)

description of formations encountered	from	to
<i>Sand clay</i>	<i>0</i>	<i>30</i>
<i>Sand &amp; Rocks</i>	<i>30</i>	<i>60</i>
<i>B. line</i>	<i>60</i>	<i>80</i>
<i>Rocks &amp; Sand</i>	<i>80</i>	<i>140</i>
<i>Water Sand &amp; Rocks</i>	<i>140</i>	<i>218</i>

WELL LOCATION:  
 sec. 11 T. 8 N. R. 2 E.  
4 miles NW of Pontotoc  
 (distance) (direction) (nearest town)

WELL PURPOSE: Home  
 (home, irrigation, municipal, industrial)

- WELL COMPLETION DATA:
- (1) diameter (inches) 4
  - (2) total depth (feet) 218
  - (3) static water level (feet) 30 below above top of ground.
  - (4) casing LT 69  
 (material) (depth)  
 (size) if telescope see back.
  - (5) screen 1           
 (length) (depth to top)  
 (size) (material)
  - (6) pump 1/2 1180  
 (HP) (yield gpm)  
EP 020  
 (type power)
  - (7) electric log           
 (yes or no)  
 (organization running log)
  - (8) how well bottom plugged

**CODED**


DEC 10 1968

DRILLERS REMARKS:         

MISS. DIV. OF  
 WATER CONSERV.

If well telescopes please  
sketch and show depths.

GROUND LEVEL

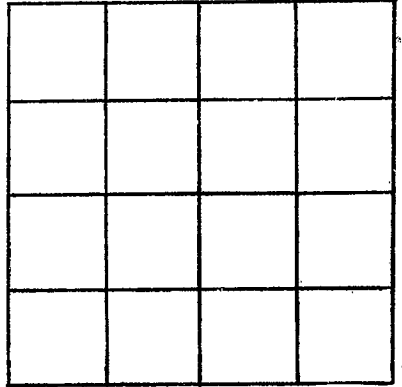

SECTION \_\_\_\_\_

Please indicate well location X.

ADDITIONAL INFORMATION

If more than one screen,  
show locations of each on sketch.