

PONTOTOC
B97
1-15-73

MISSISSIPPI
BOARD OF WATER COMMISSIONERS
416 North State Street
Jackson, Mississippi 39201

CODED

WATER WELL DRILLERS LOG

1-15-1973 Leeper Drilling Co Pontotoc
date well completed firm name county well located


| LANDOWNER: | description of formations encountered | from | to |
|--|---------------------------------------|--|----------------------|
| Wesley High Ecum, Miss - (mailing address) | | Red Clay + Sand Red Sand + Rock Blue Clay + Rock Sand - | 0 30 60 126 |
| WELL LOCATION: sec. 19 T-8 N R-2 E 2 miles N. of Ecum (distance) (direction) (nearest town) | | | |
| WELL PURPOSE: Home (home, irrigation, municipal, industrial) | | | |
| WELL COMPLETION DATA: | | | |
| (1) diameter (inches) 4 | | | |
| (2) total depth (feet) 180 | | | |
| (3) static water level (feet) 60 below top of ground. | | | |
| (4) casing Steel, 126 (material) (depth) 4 If telescope see back. (size) | | | |
| (5) screen none (length) (depth to top) (size) (material) | | | |
| (6) pump 1/2 6 (HP) (yield gpm) Elect (type power) | | | |
| (7) electric log no- (yes or no) (organization running log) | | | |
| (8) how well bottom plugged open | | | |
| DRILLERS REMARKS: | | | |

CODED

FEB 22 1973

If well telescopes please sketch and show depths.

GROUND LEVEL

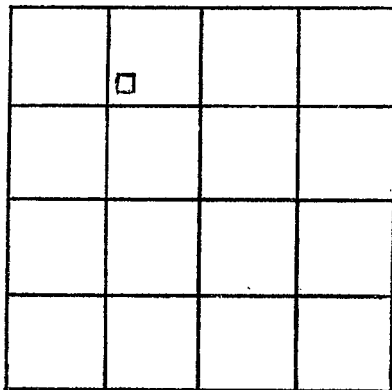

SECTION 19

Please indicate well location X.

ADDITIONAL INFORMATION

If more than one screen,
show locations of each on sketch.