

PONTOTOC

B98

11-15-72

MISSISSIPPI BOARD OF WATER COMMISSIONERS  
416 North State Street  
Jackson, Mississippi 39201

CODED

WATER WELL DRILLERS LOG

Nov 15 1972  
date well completed

Laton Autor  
firm name

PONTOTOC  
county well located

LANDOWNER: B. B. Bramlet

description of formations encountered	from	to
Red + White Loam	0	30
Limestone	30	60
Blue Shale	60	130
Rock + Sand	130	250

Ecru Rt. 1.  
(mailing address)

WELL LOCATION:

sec. 10 T. 9 N. S. R. 2 E  
3 1/2 miles SW of EC RU  
(distance) (direction) (nearest town)

WELL PURPOSE: Home  
(home, irrigation, municipal, industrial)

WELL COMPLETION DATA:

- (1) diameter (inches) 4
- (2) total depth (feet) 250
- (3) static water level (feet) 65 below top of ground.
- (4) casing Steel 8 1/2 (material) (depth)
- 4 (size) if telescope see back.
- (5) screen (length) (depth to top)
- (size) (material)
- (6) pump 1 (HP) 8 (yield gpm)
- Electric (type power)
- (7) electric log no (yes or no)
- (organization running log)
- (8) how well bottom plugged

CODED


MAR 19 1972

DRILLERS REMARKS:

MISS. DIV. OF WATER RESOURCES

If well telescopes please sketch and show depths.

GROUND LEVEL

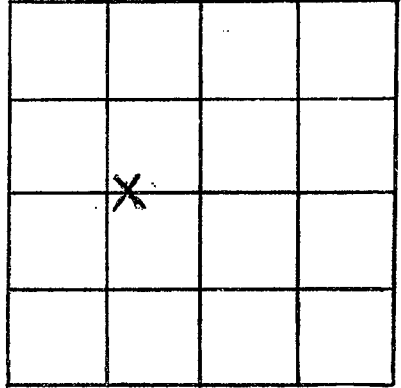

SECTION 10

Please indicate well location X.

ADDITIONAL INFORMATION

The reason for late report - The detailed description was not available until now.

If more than one screen, show locations of each on sketch.