

PONTOTOC  
B99  
12-15-72

MISSISSIPPI  
BOARD OF WATER COMMISSIONERS  
416 North State Street  
Jackson, Mississippi 39201

CODED

WATER WELL DRILLERS LOG

12-15 1972 date well completed      Laton Auter firm name      Pontotoc county well located

LANDOWNER:  
TROY GRAHAM  
Rt 2, PONTOTOC  
(mailing address)

description of formations encountered	from to	
White Loam	0	21
Blue Limestone	21	50
Blue Shale	50	125
Rock + Sand	125	240

WELL LOCATION:  
sec 22 T 9 N R 2 E  
S W  
4 miles West of Pontotoc  
(distance) (direction) (nearest town)

WELL PURPOSE: HOME  
(home, irrigation, municipal, industrial)

WELL COMPLETION DATA: 12-15-72


- (1) diameter (inches) 4
- (2) total depth (feet) 240
- (3) static water level (feet) 120 below top of ground.
- (4) casing Steel 106" (material) (depth)
- 4 (size) if telescope see back.
- (5) screen (length) (depth to top)
- (size) (material)
- (6) pump 1 8 (HP) (yield gpm)
- Electric (type power)
- (7) electric log no (yes or no)
- (organization running log)
- (8) how well bottom plugged

CODED

DRILLERS REMARKS:

If well telescopes please sketch and show depths.

GROUND LEVEL

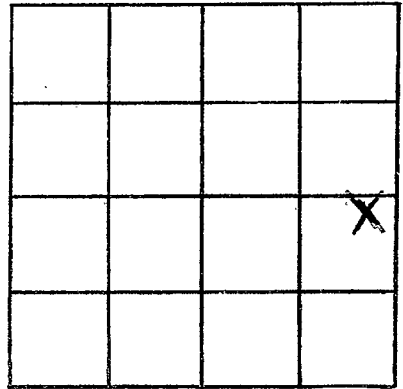

SECTION 22

Please indicate well location X.

ADDITIONAL INFORMATION

*This man also very  
recently got his dead*

If more than one screen,  
show locations of each on sketch.