

PONTOTOC

B100

1-17-73

MISSISSIPPI BOARD OF WATER COMMISSIONERS  
416 North State Street  
Jackson, Mississippi 39201

**CODED**

WATER WELL DRILLERS LOG

*Laton Zuter Pontotoc*

1-17 1973  
date well completed

firm name

county well located

LANDOWNER:

Richard Wells

RT. #2 PONTOTOC  
(mailing address)

description of formations encountered

White Loam

from

to

0 18

Limestone

18 50

Blue Shale

50 111

Rock & Sand

111 220

WELL LOCATION:

sec 14 T 9 N S R 2 E  
3 3/4 miles S.W. of ECRU  
(distance) (direction) (nearest town)

WELL PURPOSE: Home  
(home, irrigation, municipal, industrial)

WELL COMPLETION DATA: 1-17-73

(1) diameter (inches) 4  
(2) total depth (feet) 220

(3) static water level (feet) 56 below above top of ground.

(4) casing 4 105  
(material) (depth)

4 if telescope see back.  
(size)

(5) screen R  
(length) (depth to top)

(size) (material)

(6) pump 1 8  
(HP) (yield gpm)

Electric  
(type power)

(7) electric log No  
(yes or no)

(organization running log)

(8) how well bottom plugged


**CODED**

WELL LOG NO. 1-17-73

DRILLERS REMARKS:

If well telescopes please sketch and show depths.

GROUND LEVEL

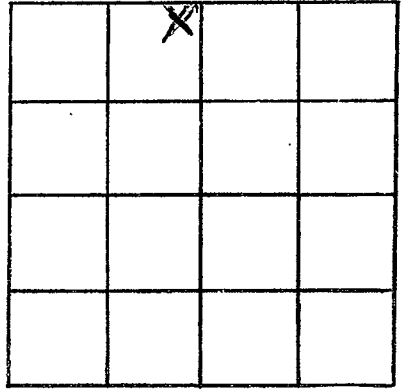

SECTION 14

Please indicate well location X.

ADDITIONAL INFORMATION

*This man. Wesley  
recently got his deed  
recorded -*

If more than one screen,  
show locations of each on sketch.