

PONTOTOC

B101

3-14-73

MISSISSIPPI BOARD OF WATER COMMISSIONERS
416 North State Street
Jackson, Mississippi 39201

WATER WELL DRILLERS LOG

3-14 1973
date well completed

Haten Inter
firm name

PONTOTOC
well located

LANDOWNER:
Ottis GRAHAM
Rt 1 ECRU
(mailing address)

description of formations encountered	from	to
White loam	0	24
Limestone	24	100
Blue shale	100	120
Rock + Sand	120	200

WELL LOCATION:
sec. 12 T. 09 N. R. 2 E
3 1/2 miles S.W. ECRU
(distance) (direction) (nearest town)

WELL PURPOSE: Home
(home, irrigation, municipal, industrial)

WELL COMPLETION DATA: 3-14-73

- (1) diameter (inches) 4
- (2) total depth (feet) 200
- (3) static water level (feet) 53 below top of ground
- (4) casing Steel 84' (material) (depth)
4" (size) if telescope see back.
- (5) screen (length) (depth to top)
(size) (material)
- (6) pump 1 (HP) 8 (yield gpm)
Electric (type power)
- (7) electric log No (yes or no)

CODED

(organization running log)


(8) how well bottom plugged

DRILLERS REMARKS:

MAR 29 1973

If well telescopes please sketch and show depths.

GROUND LEVEL

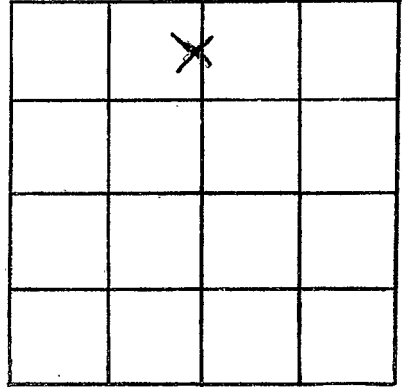

SECTION 12

Please indicate well location X.

ADDITIONAL INFORMATION

If more than one screen,
show locations of each on sketch.