

PONTOTOC  
 B 102  
 2-27-73

MISSISSIPPI  
 BOARD OF WATER COMMISSIONERS  
 416 North State Street  
 Jackson, Mississippi 39201

**CODED**

WATER WELL DRILLERS LOG

*Katon Autor Pontotoc*

2-27-1973  
 date well completed

firm name

county well located

LANDOWNER:  
*Dewitt Gates*  
*RT#2 PONTOTOC*  
 (mailing address)

description of formations encountered	from	to
<i>Red clay</i>	<i>0</i>	<i>24</i>
<i>Limestone</i>	<i>24</i>	<i>50</i>
<i>Blue SHALE</i>	<i>50</i>	<i>90</i>
<i>Rock + Sand</i>	<i>90</i>	<i>200</i>

WELL LOCATION:  
 sec. *12* T. *9* N R. *20* E  
*4* miles *S* of *ECRU*  
 (distance) (direction) (nearest town)

WELL PURPOSE: *Home*  
 (home, irrigation, municipal, industrial)

WELL COMPLETION DATA: *2-27-73*

- (1) diameter (inches) *4*
- (2) total depth (feet) *200*
- (3) static water level (feet) *55* below above top of ground.
- (4) casing *Steel*, *63*,  
 (material) (depth)  
*4* If telescope see back.  
 (size)
- (5) screen *2*,  
 (length) (depth to top)  
 (size) (material)
- (6) pump *1*, *3*  
 (HP) (yield gpm)  
*Electric*  
 (type power)
- (7) electric log *No*  
 (yes or no)
- (8) how well bottom plugged


**CODED**

APPROVED BY  
 MISSISSIPPI BOARD OF WATER COMMISSIONERS

DRILLERS REMARKS:

If well telescopes please sketch and show depths.

GROUND LEVEL

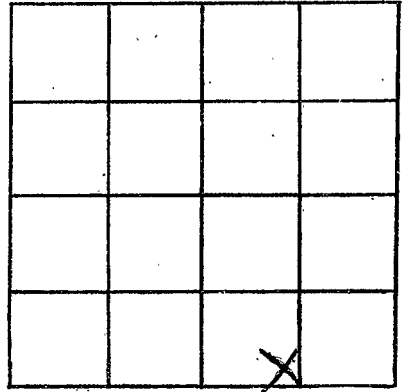

SECTION 12

Please indicate well location X.

ADDITIONAL INFORMATION

If more than one screen,  
show locations of each on sketch.