

PONTOTOC
B 103,
2-19-73

MISSISSIPPI
BOARD OF WATER COMMISSIONERS
416 North State Street
Jackson, Mississippi 39201

CODED

WATER WELL DRILLERS LOG

2-19-1973 date well completed Latorator firm name PONTOTOC county well located

LANDOWNER:
BURR, GRAHAM
RT-1, ECRU
(mailing address)

description of formations encountered	from	to
<u>White Loam</u>	<u>0</u>	<u>28</u>
<u>limestone</u>	<u>28</u>	<u>55</u>
<u>Blue Shale</u>	<u>55</u>	<u>108</u>
<u>Rock + Sand</u>	<u>108</u>	<u>230</u>

WELL LOCATION:
sec. 11 T-9 N R 2 E
3 1/2 miles S.W. of ECRU
(distance) (direction) (nearest town)

WELL PURPOSE: HOME
(home, irrigation, municipal, industrial)

WELL COMPLETION DATA: 2-19-73

- (1) diameter (inches) 4
- (2) total depth (feet) 230
- (3) static water level (feet) 68 below above top of ground.
- (4) casing Steel 4 1/2" (material) (depth)
- 4 (size) If telescope see back.
- (5) screen Ø (length) (depth to top)
- (size) (material)
- (6) pump 1 (HP) 8 (yield gpm)
- Electric (type power)
- (7) electric log (yes or no)
- (organization running log)
- (8) how well bottom plugged ✓


CODED

MAR 10 1973

DRILLERS REMARKS:

If well telescopes please sketch and show depths.

GROUND LEVEL

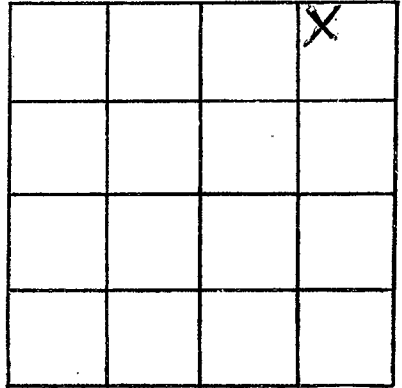

SECTION 11

Please indicate well location X.

ADDITIONAL INFORMATION

If more than one screen,
show locations of each on sketch.