

PONTOTOC

B104

11-1-72

MISSISSIPPI BOARD OF WATER COMMISSIONERS
416 North State Street
Jackson, Mississippi 39201

CODED

WATER WELL DRILLERS LOG

Nov. 1 - 1972
date well completed

Laton A. Auter
firm name

PONTOTOC
county well located

LANDOWNER: RICHARD

MCYLOFFIN

RT 2 PONTOTOC
(mailing address)

description of formations
encountered

from

to

White loam

0

26

Limestone

26

40

Brown sand

40

60

Blue SHALE

60

150

Rock + Sand

150

270

WELL LOCATION:

sec. 19 T 8 S R 2 E
1 1/2 miles East of Hunicama
(distance) (direction) (nearest town)

WELL PURPOSE: HOME
(home, irrigation, municipal, industrial)

WELL COMPLETION DATA: 11-72

- (1) diameter (inches) 4.11
- (2) total depth (feet) 270
- (3) static water level (feet) 28 below top of ground.
- (4) casing Steel 84' (material) (depth)
4' (size) if telescope see back.
- (5) screen (length) (depth to top)
(size) (material)
- (6) pump 3/4 HP 8 (HP) (yield gpm)
Electric (type power)
- (7) electric log no (yes or no)

(organization running log)

(8) how well bottom plugged

DRILLERS REMARKS:


CODED

MAD 10 1972

MISS. Bd. of
Water Comm.

If well telescopes please sketch and show depths.

GROUND LEVEL

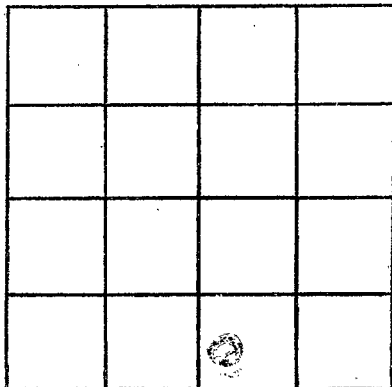

SECTION 19

Please indicate well location X.

ADDITIONAL INFORMATION

The reasons for late report. The detailed description was not available until now.

If more than one screen, show locations of each on sketch.