

PONTOTOC
 B 109
 6-15-73

MISSISSIPPI
 BOARD OF WATER COMMISSIONERS
 416 North State Street
 Jackson, Mississippi 39201

CODED

WATER WELL DRILLERS LOG

6-15-1973 date well completed
 Leeper Drilling Co. firm name
 Pontotoc county well located

LANDOWNER:

Carter, Dandy -
 Ecw, Miss -
 (mailing address)

description of formations encountered

from	to
0	20
20	35
35	120
120	190
190	285

White Clay -
 White Clay & sand
 Blue Clay -
 Blue Clay & Rock
 Sand -

WELL LOCATION:

sec 21 T 8 S R 2 E
 5 miles W of Ecw
 (distance) (direction) (nearest town)

CODED


WELL PURPOSE:

Home (home, irrigation, municipal, industrial)

WELL COMPLETION DATA:

- (1) diameter (inches) 4
- (2) total depth (feet) 285
- (3) static water level (feet) 40 below top of ground.
- (4) casing Steel, 84 (material) (depth)
 4 (size) If telescope see back.
- (5) screen (length) (depth to top)
 (size) (material)
- (6) pump 1/2 (HP) 10 (yield gpm)
 Elect (type power)
- (7) electric log no (yes or no)
 (organization running log)
- (8) how well bottom plugged Open


DRILLERS REMARKS:

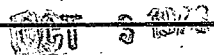

MISS.
 WATER

If well telescopes please sketch and show depths.

GROUND LEVEL

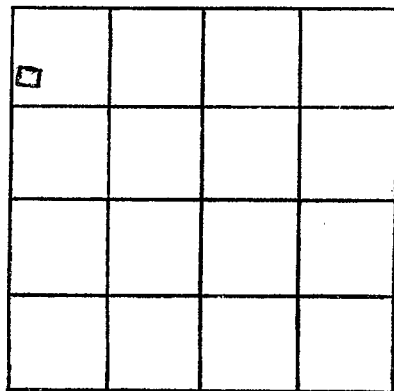

SECTION 21

Please indicate well location X.

ADDITIONAL INFORMATION

If more than one screen,
show locations of each on sketch.