

PONTOTOC
 B III
 1-23-74

MISSISSIPPI
 BOARD OF WATER COMMISSIONERS
 416 North State Street
 Jackson, Mississippi 39201

CODED

WATER WELL DRILLERS LOG

1-23-1974 *Leiper* *Pontotoc*
 date well completed firm name county well located

LANDOWNER:
W. M. Rainer
Pontotoc, Miss.
 (mailing address)


description of formations encountered	from	to
<i>Top Soil & Clay</i>	<i>0</i>	<i>20</i>
<i>Rd. Clay + Rock</i>	<i>20</i>	<i>40</i>
<i>Rock & Sand</i>	<i>40</i>	<i>80</i>
<i>Blue Clay</i>	<i>80</i>	<i>126</i>
<i>Blue clay & Rock</i>	<i>126</i>	<i>140</i>
<i>Sand</i>	<i>140</i>	<i>207</i>

WELL LOCATION:
 sec. *25* T *9* N R *20*
2 miles *W* of *Pontotoc*
 (distance) (direction) (nearest town)

WELL PURPOSE: *Home*
 (home, irrigation, municipal, industrial)

- WELL COMPLETION DATA:
- (1) diameter (inches) *4*
 - (2) total depth (feet) *207*
 - (3) static water level (feet) *80* below above top of ground.
 - (4) casing *Steel*, *126*
 (material) (depth)
 (size) if telescope see back.
 - (5) screen *none*
 (length) (depth to top)
 (size) (material)
 - (6) pump *3/4* *7*
 (HP) (yield gpm)
Electric
 (type power)
 - (7) electric log *no*
 (yes or no)
 - (8) how well bottom plugged *Open*
 (organization running log)

CODED

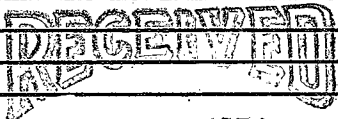


MAR 21 1974

MISS. BD. OF WATER COMMISSIONERS

DRILLERS REMARKS:

If well telescopes please sketch and show depths.

GROUND LEVEL

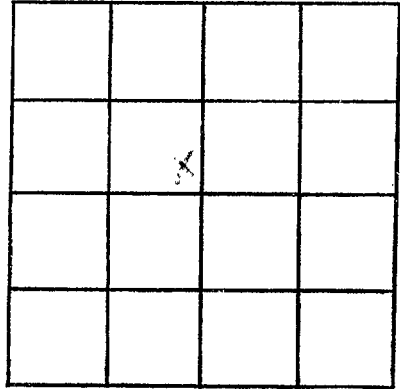

SECTION _____

Please indicate well location X.

ADDITIONAL INFORMATION

If more than one screen,
show locations of each on sketch.