

PONTOTOC
 B 112
 A-15-74

MISSISSIPPI
 BOARD OF WATER COMMISSIONERS
 416 North State Street
 Jackson, Mississippi 39201

WATER WELL DRILLERS LOG

April 15 1974 J.W. Webb & Sons Pontotoc
 date well completed firm name county well located

LANDOWNER: Kenneth Warren

description of formations encountered from to

~~Hurricane~~
 Ecru
 (mailing address)

Soil	0	1
Shale & Clay	1	49
Blue ROCKED	49	260
Water Rock	260	261
Water sand	261	340
Ripley sand		


WELL LOCATION:
 sec. 19 T. 8 N R. 2 E
 2 miles East of Hurricane
 (distance) (direction) (nearest town)

WELL PURPOSE:
 (home, irrigation, municipal, industrial)

WELL COMPLETION DATA:


- (1) diameter (inches) 4"
- (2) total depth (feet) 340
- (3) static water level (feet) 63 below above top of ground.
- (4) casing Steel, 63 ft. (material) (depth)
 4 (size) if telescope see back.
- (5) screen 0 (length) 0 (depth to top)
 0 (size) (material)
- (6) pump 1/2 HP, 8 (HP) (yield gpm)
 Elec (type power)
- (7) electric log (yes or no)
 (organization running log)
- (8) how well bottom plugged

DRILLERS REMARKS:

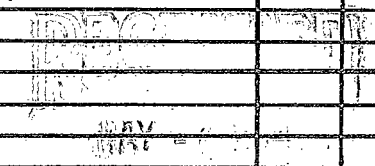

If well telescopes please sketch and show depths.

GROUND LEVEL

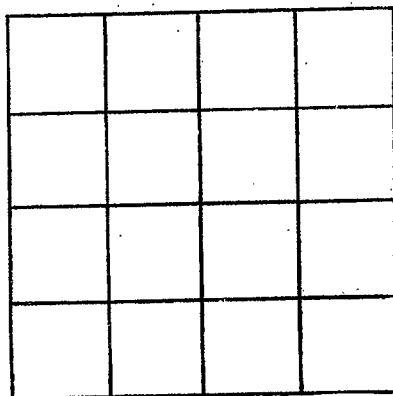

SECTION _____

Please indicate well location X.

ADDITIONAL INFORMATION

If more than one screen, show locations of each on sketch.