

PONTOTOC
 B 113
 4-23-74

MISSISSIPPI
 BOARD OF WATER COMMISSIONERS
 416 North State Street
 Jackson, Mississippi 39201 CODED

WATER WELL DRILLERS LOG

April 23 1974 J. W. Webb & Sons Pontotoc
 date well completed firm name county well located

LANDOWNER: Naomi Alderson
 Eum Miss

description of formations encountered	from	to
Soil	0	6
Pipe Clay	6	13
Sand & Hard Rocks	18	55
Blue Rock	55	141
Water Rock	141	200
Replay sand		

(mailing address)

WELL LOCATION:
 sec 11 T 9 N R 2 E
 2 1/2 miles south of Eum
 (distance) (direction) (nearest town)

WELL PURPOSE:
 (home, irrigation, municipal, industrial)


- WELL COMPLETION DATA:
- (1) diameter (inches) 4
 - (2) total depth (feet) 200 ft
 - (3) static water level (feet) 60 below top of ground.
 - (4) casing Steel 63' (material) (depth)
 - (size) If telescope see back.
 - (5) screen (length) (depth to top)
 - (size) (material)
 - (6) pump 1/2 HP 8 (HP) (yield gpm)
 - Elec (type power)
 - (7) electric log (yes or no)
 - (organization running log)
 - (8) how well bottom plugged

DRILLERS REMARKS:

MAY 6 1974

If well telescopes please sketch and show depths.

GROUND LEVEL

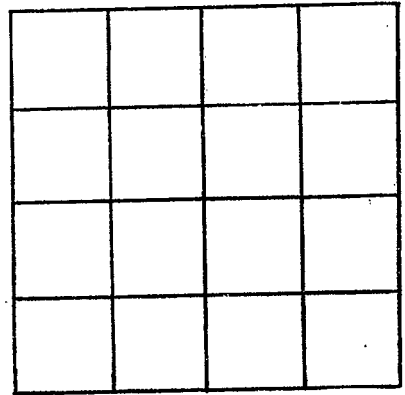

SECTION _____

Please indicate well location X.

ADDITIONAL INFORMATION

If more than one screen, show locations of each on sketch.