

**MISSISSIPPI  
BOARD OF WATER COMMISSIONERS**  
416 North State Street  
Jackson, Mississippi 39201

**CODED**

**WATER WELL DRILLERS LOG**

**PONTOTOC**  
**B 114**  
**7-5-74**

July 5, 1974 date well completed      Bahly L. Sworb Pontotoc firm name      Pontotoc county well located

**LANDOWNER:**

William Bramlett  
Florida  
(mailing address)

**description of formations encountered**

white clay  
Blue mud  
Rock + Sand

from to

0 20  
20 140  
140 285

**WELL LOCATION:**

sec 30 T 9 N R 2 E  
S W  
6 miles west of Pontotoc  
(distance) (direction) (nearest town)

**WELL PURPOSE:**

Home  
(home, irrigation, municipal, industrial)

**WELL COMPLETION DATA:**

- (1) diameter (inches) 4"
- (2) total depth (feet) 285
- (3) static water level (feet) 86 below top of ground.
- (4) casing Steel, 80 ft.  
(material) (depth)  
4" if telescope see back.  
(size)
- (5) screen none  
(length) (depth to top)  
(size) (material)
- (6) pump 1 H.P. 2 stages 8 gpm  
(HP) (yield gpm)  
Electric  
(type power)
- (7) electric log \_\_\_\_\_  
(yes or no)  
(organization running log)
- (8) how well bottom plugged \_\_\_\_\_

**CODED**


**DRILLERS REMARKS:**

**RECEIVED**  
JUL 26 1974

MISS. BD. OF WATER COMM

If well telescopes please sketch and show depths.

GROUND LEVEL

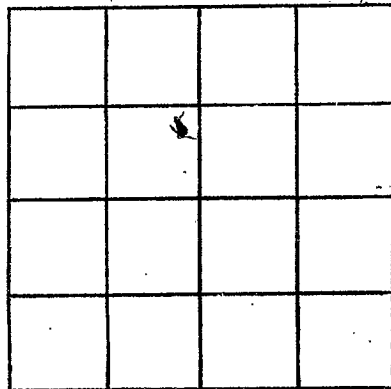

SECTION \_\_\_\_\_

Please indicate well location X.

ADDITIONAL INFORMATION

If more than one screen,  
show locations of each on sketch.