

PONTOTOC  
B 115  
8-16-74

MISSISSIPPI  
BOARD OF WATER COMMISSIONERS  
416 North State Street  
Jackson, Mississippi 39201

WATER WELL DRILLERS LOG

CODED

Aug. 10 1974 Bahly L. Swords Pontotoc  
date well completed firm name county well located

LANDOWNER: Mike Horton  
Pontotoc, Miss.

description of formations  
encountered

from to

white sand	0	30
blue mud	30	310
rock + sand	310	385

(mailing address)

WELL LOCATION:

sec 27 T 8 R 2 E  
5 miles SW of FCR  
(distance) (direction) (nearest town)

WELL PURPOSE: Home  
(home, irrigation, municipal, industrial)

WELL COMPLETION DATA:

- (1) diameter (inches) 4"
- (2) total depth (feet) 385
- (3) static water level (feet) 20 below top of ground.
- (4) casing Steel 67, (material) (depth)  
4" (size) if telescope see back.
- (5) screen none (length) (depth to top)  
(size) (material)
- (6) pump (HP) (yield gpm)  
(type power)
- (7) electric log (yes or no)  
(organization running log)
- (8) how well bottom plugged


DRILLERS REMARKS:

RECEIVED

AUG 21 1974

If well telescopes please sketch and show depths.

GROUND LEVEL

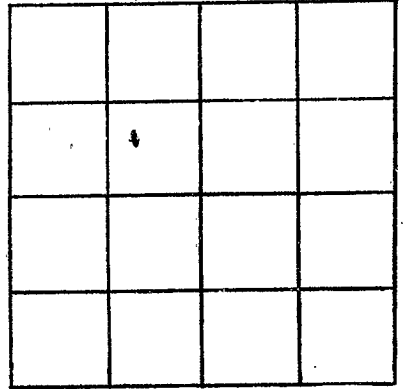

SECTION 27

Please indicate well location X.

ADDITIONAL INFORMATION

If more than one screen,  
show locations of each on sketch.