

PONTOTOC
 B 116
 7-6-74

MISSISSIPPI
 BOARD OF WATER COMMISSIONERS CODED
 416 North State Street
 Jackson, Mississippi 39201

WATER WELL DRILLERS LOG

7-6-1974 date well completed Leeper first name Pontotoc county well located

LANDOWNER:
 Saint Johns Baptist Church
 Ecru, Miss.
 (mailing address)

description of formations encountered	from	to
Red Clay + Rock	0	20
Rock + Chalk	20	60
Rock + Blue Clay	60	105
Blue Clay	105	130
Rock + Sand	130	180

WELL LOCATION:
 sec. 36 T 8 S R 2 E
 3 miles SW of Ecru
 (distance) (direction) (nearest town)

WELL PURPOSE: Church
 (home, irrigation, municipal, industrial)

- WELL COMPLETION DATA:
- (1) diameter (inches) 4
 - (2) total depth (feet) 180
 - (3) static water level (feet) 80 below top of ground.
 - (4) casing Steel 105 (material) (depth)
 - (size) if telescope see back.
 - (5) screen none (length) (depth to top)
 - (size) (material)
 - (6) pump 1/2 (HP) 9 (yield gpm)
 - Elect (type power)
 - (7) electric log no- (yes or no)
 - (organization running log)
 - (8) how well bottom plugged Open


RECEIVED

SEP 18 1974

DRILLERS REMARKS:

If well telescopes please sketch and show depths.

GROUND LEVEL

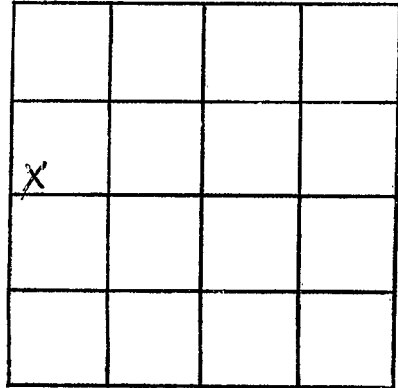

SECTION 36

Please indicate well location X.

ADDITIONAL INFORMATION

A series of horizontal lines for writing additional information.

If more than one screen, show locations of each on sketch.