

PONTOTAC
B 117
7-20-74

MISSISSIPPI
BOARD OF WATER COMMISSIONERS
416 North State Street
Jackson, Mississippi 39201 CODED

WATER WELL DRILLERS LOG

7-20-1974
date well completed

Leper
firm name

Pontotac
county well located

LANDOWNER:

Amos Rooker
Ecu, Miss
(mailing address)

description of formations
encountered

	from	to
Red clay & Rock	0	20
Rock & Chalk	20	60
Rock & Blue clay	60	105
Blue clay	105	130
Rock & Sand	130	180

WELL LOCATION:

sec. 36 T. 8 S. R. 2 E
3 miles SW of Ecu
(distance) (direction) (nearest town)

WELL PURPOSE: Home
(home, irrigation, municipal, industrial)

WELL COMPLETION DATA:

- (1) diameter (inches) 4/80
- (2) total depth (feet) 180
- (3) static water level (feet) 80 below top of ground
- (4) casing Steel, 105
(material) (depth)
(size) if telescope see back.
- (5) screen wire
(length) (depth to top)
(size) (material)
- (6) pump 1/2 9
(HP) (yield gpm)
Elect
(type power)
- (7) electric log no
(yes or no)
- (organization running log)
- (8) how well bottom plugged open


DRILLERS REMARKS:

RECEIVED
SEP 18 1974

MISS. BD. OF WATER COMMISSIONERS

If well telescopes please sketch and show depths.

GROUND LEVEL

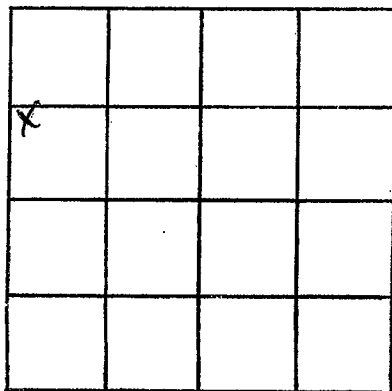

SECTION 36

Please indicate well location X.

ADDITIONAL INFORMATION

Lined area for additional information.

If more than one screen, show locations of each on sketch.