

PONTOTOC
B 118
3-7-75

MISSISSIPPI
BOARD OF WATER COMMISSIONERS
416 North State Street
Jackson, Mississippi 39201

WATER WELL DRILLERS LOG

3-7-75 date well completed
J.W. Webb & Son firm name
PONTOTOC county well located

CODED

LANDOWNER: Ronnie Borjesson

Description of formations encountered	from	to
Soil	0	1
Clay Shale	1	63
Blue Rock	63	195
Water Rock	195	203
Water Sand & Rocks	203	300
Replay Sand		

ECRU Miss
(mailing address)

WELL LOCATION:
sec. 28 T. 8 N. R. 20 W.
4 miles West of ECRU
(distance) (direction) (nearest town)

WELL PURPOSE:
(home, irrigation, municipal, industrial)

WELL COMPLETION DATA:

- (1) diameter (inches) 4"
- (2) total depth (feet) 300
- (3) static water level (feet) 44 below above top of ground.
- (4) casing steel, 84" (material), (depth)
4" (size) if telescope see back.
- (5) screen 0 (length) (depth to top)
(size) (material)
- (6) pump 1-1/2 HP 6 (HP) (yield gpm)
Elec (type power)
- (7) electric log (yes or no)
(organization running log)
- (8) how well bottom plugged

CODED


RECEIVED
APR 28 1975

DRILLERS REMARKS:

OFFICE OF THE WATER COMMISSIONER

If well telescopes please sketch and show depths.

GROUND LEVEL

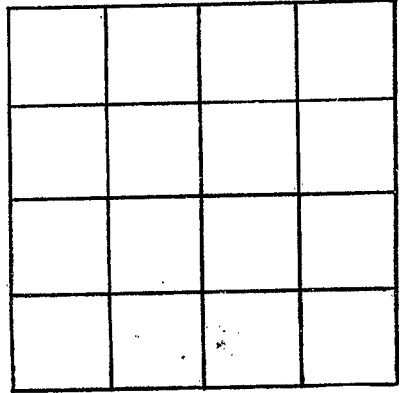

SECTION _____

Please indicate well location X.

ADDITIONAL INFORMATION

If more than one screen, show locations of each on sketch.