

PONTOTOC  
 B119  
 5-14-75

MISSISSIPPI  
 BOARD OF WATER COMMISSIONERS  
 416 North State Street  
 Jackson, Mississippi 39201

WATER WELL DRILLERS LOG

5/14 1975 date well completed  
 Herman Homan Well & Supply, Inc. 021  
 P.O. Box 42  
 SHANNON MISSISSIPPI 38868  
 P. CODED  
 county well located


LANDOWNER:	description of formations encountered	from	to
Harold Mills	submer sand	0	55
Pontotoc Miss. (mailing address)	blue clay	55	100
	Shale	100	220
	Shale	220	
<b>WELL LOCATION:</b> sec. <u>25</u> T. <u>9</u> N. R. <u>2</u> E. S. <u>5</u> W. <u>1</u> miles <u>NW</u> of <u>Pontotoc</u> (distance) (direction) (nearest town)			
<b>WELL PURPOSE:</b> <u>Home</u> (home, irrigation, municipal, industrial)			
<b>WELL COMPLETION DATA:</b>			
(1) diameter (inches) <u>4"</u>			
(2) total depth (feet) <u>220'</u>			
(3) static water level (feet) <u>55'</u> below top of ground.			
(4) casing <u>steel</u> , <u>62'</u> (material) (depth)			
<u>4"</u> (size) if telescope see back.			
(5) screen <u>no</u> , (depth to top)			
(size) (material)			
(6) pump <u>1/2</u> , <u>5</u> (HP) (yield gpm)			
<u>elect</u> (type power)			
(7) electric log <u>NO</u> (yes or no)			
(organization running log)			
(8) how well bottom plugged <u>open</u>			
<b>DRILLERS REMARKS:</b>			

RECEIVED  
 MISSISSIPPI  
 MAY 19 1975

MISS. DD. OF WATER

If well telescopes please sketch and show depths.

GROUND LEVEL

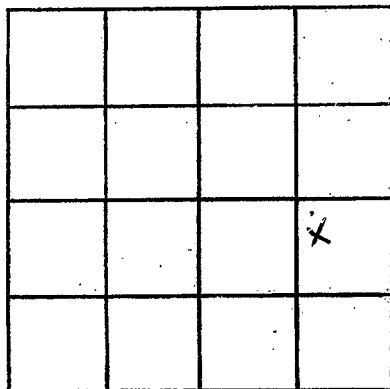

SECTION 25

Please indicate well location X.

ADDITIONAL INFORMATION

If more than one screen, show locations of each on sketch.