

Porttore  
B 121  
7-2-75

MISSISSIPPI  
BOARD OF WATER COMMISSIONERS  
416 North State Street  
Jackson, Mississippi 39201

CODED

WATER WELL DRILLERS LOG

7 2 19 75 Bobby L. Swartz Porttore  
date well completed firm name county well located

LANDOWNER: Royce Newby  
Rt. 4  
New Albany, Miss.  
(mailing address)

description of formations encountered	from	to
<u>white clay</u>	<u>0</u>	<u>20</u>
<u>blue mud</u>	<u>20</u>	<u>230</u>
<u>rock &amp; sand</u>	<u>230</u>	<u>285</u>

WELL LOCATION:  
sec. 17 T 9 N R 2 E  
8 miles Sweet Escal of  
(distance) (direction) (nearest town)

WELL PURPOSE: Home  
(home, irrigation, municipal, industrial)

- WELL COMPLETION DATA:
- (1) diameter (inches) 4"
  - (2) total depth (feet) 285
  - (3) static water level (feet) 17 below above top of ground.
  - (4) casing Steel 84ft  
(material) (depth)  
4 if telescope see back.  
(size)
  - (5) screen none  
(length) (depth to top)  
(size) (material)
  - (6) pump none  
(HP) (yield gpm)  
(type power)
  - (7) electric log \_\_\_\_\_  
(yes or no)  
(organization running log)
  - (8) how well bottom plugged \_\_\_\_\_

CODED

DRILLERS REMARKS:


RECEIVED  
AUG 7 1975

AUG 7 1975

MISSISSIPPI WATER COMMISSION

If well telescopes please sketch and show depths.

GROUND LEVEL

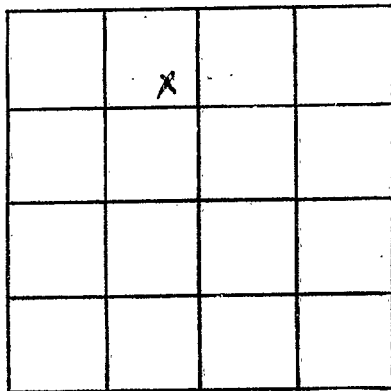

SECTION 17

Please indicate well location X.

ADDITIONAL INFORMATION

If more than one screen,  
show locations of each on sketch.