

State Well Report

Part 1

Mississippi Department of Environmental Quality
Office of Land and Water Resources
P.O. Box 10631
Jackson, MS 39289-0631
(601)961-5210
(601)354-6938 (fax)

For Office Use Only:

Aquifer: _____
Well #: B-153
L. S. Elevation: _____
E-log #: _____

County: Pontotoc
Permit #: _____
Driller: Leeper Drilling
Date drilling completed: 3-12-07

State Law requires that this report be prepared by the driller in detail and filed with the Department within 30 days of completion of drilling of the well.

Well Owner Information

Owner Name: Lawrence Lindley
Mailing Address: Rocky Ford Road
Pontotoc, MS 38863
City State Zip Code
Telephone No. (662) - 417-6927

Well Location

Latitude: _____ Longitude: _____
Method of Lat/Long (circle one): Conventional Survey,
USGS quad, Hand-held GPS, Survey-grade GPS
____ 1/4 ____ 1/4 Sec 16 Twn 9S Rng 2E
Distance Direction Nearest Town
5 Miles NW of Pontotoc


Well Data

Purpose of Well (circle one) Home Industrial Public Supply Irrigation Fish Culture Other: _____
Date well drilling started: 3-12-07 Date well drilling completed: 3-12-07
If flowing, method of flow regulation: Valve _____ Other (describe) _____
Static Water Level: 65' feet above or below (circle one) land surface Date measured: 3-13-07
Method of Measurement (circle one) steel tape electric tape air line other: _____
Hole depth: 240 ft Well depth: 240 ft Well grouted to a depth of 10 feet
Type of grout (circle one): Cement Bentonite Mix
Casing length: 160 feet Casing diameter: 4" inches Type of casing: PVC
Screen length: 40 feet Screen diameter: 2" inches Type of screen: PVC
Screen slot size: 10/16 inches Setting depth: From 200 feet to 240 feet
Type of completion (circle all applicable): Gravel packed Underreamed Telescoped Open hole Natural Development
Other (describe): _____
Top of lap pipe or reduction in casing: _____ feet. If telescoped or more than one screen, describe on back of page
Logs run (circle all applicable): No log run Electric Gamma Ray Density Sonic Neutron Other: _____
Name of organization running log(s): _____

I certify that the well was drilled, constructed, and completed in accordance with all applicable requirements of the Mississippi Department of Environmental Quality and/or the Mississippi Department of Health regulations and state laws.

Leeper Drilling # 0079
Print Name of Water Well Contractor and License No.

Signature of Water Well Contractor

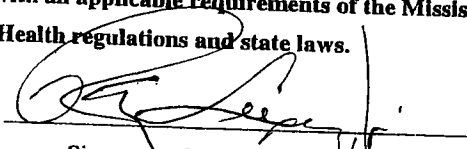

RECEIVED

MAR 29 2007

BY: OLWF

STATE WELL REPORT

Part 2

Pump Installer's Completion Report
Mississippi Department of Environmental Quality
Office of Land and Water Resources
P.O. Box 10631
Jackson, MS 39289-0631
(601)961-5210
(601)354-6938 (fax)

For Office Use Only:

Aquifer: _____
Well #: B-153
Elevation: _____

County: Port Lute
Permit #: _____
Driller: Leaper Drilling
Date completed: 3-13-07

This report should be prepared by the pump installer in detail and filed with the Department within 30 days of the installation of pump.

Well Owner Information

Owner Name: Lawrence Lindley
Mailing Address: Rocky Ford Road
Port Lute MS 3863
City State Zip Code
Telephone No. 663 417-6927

Well Location

Latitude: _____ Longitude: _____
Method of Lat/Long (circle one): Conventional Survey, USGS quad, Hand-held GPS, Survey-grade GPS
____ 1/4 ____ 1/4 Sec 14 Twn 9S Rng 2E
Distance Direction Nearest Town
5 Miles NW of Port Lute

Pump Type

Circle one

Air Lift Jet Submersible
Bucket Piston Turbine
Centrifugal Rotary Flowing Well
Other (specify): _____
Date Pump Installed: 3-13-07
Rated Pump Capacity: 10 Gallons Per Minute

Power Type

Circle one

Diesel Engine Gasoline Engine Natural Gas
 Electric Motor Hand Tractor PTO
Windmill Other (specify): _____
Horse Power Rating of Motor: 3/4 HP
Setting Depth: 110 feet
Number of Stages: 11

Pump Test Data

Date Well Tested: 3-13-07
Static Water Level (A): 65 Feet Below Land Surface
Pumping Water Level (B): _____ Feet Below Land Surface
Drawdown [(B) - (A)]: _____ Feet Below Land Surface
Test Pumping Rate: _____ Gallons Per Minute
Duration of Pump Test (minimum 4 hours): _____ hours

Method of Measuring Water Level

Circle one

Air Line Electric Measuring Line Steel Tape
Other (specify): _____
For flowing well, measured shut in head: _____ feet
Well yielded _____ GPM with a drawdown of _____ feet after _____ hours of pumping

I HEREBY CERTIFY that the above statements are true to the best of my knowledge.

Leaper Drilling # 0079
Print Name of Pump Installer and License No. (if applicable)

[Signature]
Signature of Pump Installer

RECEIVED
MAR 29 2007
BY: OLWF