
| $\Box D$   | State V  | Vell Report                                |                             |
|--|--|--|-----------------------------|
| County: TON-totoc  | Part 1   |  | For Office Use Only:        |
| Permit #:  | Mississippi Department of Environmental Quality      |  | Aquifer:                    |
| Driller: Larger Drilling   | Office of Land and Water Resources<br>P.O. Box 10631 |  | Well #: B-155               |
| Date drilling completed:   | Jackson, 1   | MS 39289-0631                              |                             |
| Date attaing completed:  | (601)961-5210  |  | L. S. Elevation:            |
|  | (601)354-6938 (fax)                                  |  | R log th                    |
| State Law requires that this repo  | ortho management in the                              | l  | E-log #:                    |
| State Law requires that this repo<br>30 days of completion of drilling<br>Well Owner Informa   | of the well.   | e driller in detail and filed w            | ith the Department within   |
|  | lion   | Well                                       | Location                    |
| Owner Name Pustin M.   | ATTHEWS  |  |                             |
| Mailing Address:   | 1  | Latitude:,                                 | " Longitude:                |
| the terms in term | from La  | Method of Lat/Long (circle one             |                             |
|  |  | USGS quad, Hand-held GPS, Survey-grade GPS |                             |
| City State Zip Code  |  | 14 Sec_ 27 Twn_8 S_Rng_2E                  |                             |
| Telephone No. (263 489-6   | 784  | Distance Direction                         |                             |
|  | Well I   | Data                                       |                             |
| Purpose of Well (circle one) Home Indus  |  |  |                             |
|  | strial Public Supply                                 | Irrigation Fish Culture (                  | Other:                      |
| Date well drilling started:  | Date w   | ell drilling completed:                    | 3-1-08                      |
| a show togatation. Valve   | Other (de  | escribe)                                   |                             |
| feet abov  | e or below (circle one) la                           | and surface Date measured.                 | 3-1-08                      |
| steel  | tape electric tons                                   | • •  |                             |
| Hole depth: Well depth<br>Type of grout (circle one): Coment   | :180'  | Well grouted to a depth of                 |                             |
| Type of grout (circle one): Cement   | Bentonite (Mix                                       | )  | feet                        |
| Casing length:feet Casing c  |  | inches The second                          | 1                           |
| Screen length: <u>30</u> feet Screen of  |  | inches Type of casing:                     |                             |
| Screen slot size:  | Setting depth: E                                     | inches Type of screen:                     | ruc                         |
| Type of completion (circle all applicable): G  | revel poster t                                       |  | 1                           |
|  |  | r open non                                 |                             |
| Top of lap pipe or reduction in casing.  | Juer (describe):                                     |  |                             |
| Top of lap pipe or reduction in casing:  | feet. If teles                                       | coped or more than one screen,             | describe on back of page    |
| o an (or so an applicable). No log fun   | Electric Gamma Ray I                                 | Density Sonic Neutron Othe                 | er:                         |
| Name of organization running log(s):<br>I certify that the well was drilled construct.   |  |  | •                           |
| I certify that the well was drilled, constructe<br>Department of Environmental Quality and/o   | d, and completed in acco                             | ordance with all applicable rem            | Irements of the Mississiani |
| · · · · · · · · · · · · · · · · · · ·  | - me mussissippi Depart                              | ment of Health regulations and             | state laws.                 |
| Leeper Drilling # 00   | 179  |  |                             |
| Print Name of Water Well Contractor and Lice   | nsę No.  | Simplus of W                               | The first                   |
|  |  |  | er Well Contractor          |

i

٠

RECEIVED MAR 1.0 2008 BY OLVER If well telescopes please sketch below and show depths.

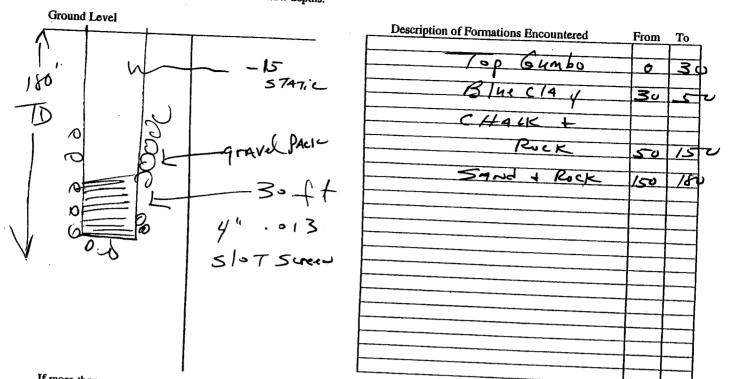

If more than one screen, show location of each on sketch

Sketch the property layout and include the following: 1) the well location; 2) any permanent structures on the property that may aid in locating the well; 3) any roads, power lines, or other items that may aid in locating the property and the well; HUME UTTON TOWN LANE ISTIN Matthews Landowner Name: Signature of Water Well Contractor

MAR 1 0 2008 BY: OLWR

B- 155

| County: Portatoc<br>Permit #:<br>Driller: Leeper Drilling<br>Date completed: 2/29/08<br>This report should be prenared by the   | Pump Instal<br>Mississippi Depart<br>Office of La<br>P.<br>Jackson<br>(601 | WELL REPORT<br>Part 2<br>ler's Completion Report<br>ment of Environmental Quality<br>and and Water Resources<br>O. Box 10631<br>n. MS 39289-0631<br>501)961-5210<br>)354-6938 (fax) | For Office Use Only:<br>Aquifer:<br>Well #: <u>B - 155</u><br>Elevation:   |
|---|--|---|--|
| This report should be prepared by the<br>Installation of pump.<br>Well Owner Information<br>Owner Name: ULS Tin Mu<br>Mailing Address:<br>Hortontow<br>City Stated<br>Telephone No US 485-67  | LLN<br>AS 38863<br>Zip Code  | Well Latitude: Method of Lat/Long (circle one USGS quad, Hand4 Sec2-  | Location<br>Longitude:<br>e): Conventional Survey,<br>held GPS, Survey-grade GPS<br>Twn <u>&amp; S</u> Rng <u>2</u> <del>C</del> |
| Bucket Piston Tu  |  | Powe<br>Circ<br>Diesel Engine Gasoline<br>Electric Motor Hand   | er Type<br>ele one<br>Engine Natural Gas<br>Tractor PTO<br>ecify):   |
| Pump Test Data         Date Well Tested:       3 - / - • &         Static Water Level (A):       /Feet Below         Pumping Water Level (B):      Feet Below         Drawdown [(B) - (A)]:      Feet Below         Test Pumping Rate:      Gallow         Duration of Pump Test (minimum 4 hours): | v Land Surface<br>v Land Surface<br>ons Per Minute                         | Method of Measure<br>Circle<br>Air Line Electric Measure<br>Other (specify):<br>For flowing well, measured shut in<br>Well yieldedG   | ng Line Steel Tape   |
| HEREBY CERTIFY that the above statements a<br>Leeper Orilling # 0079<br>Print Name of Pump Installer and License No. (if  |  |   |  |

·

MAR 1 0 2008 BY: OLW R