

Pontotoc
 B 2000
 9-17-76

MISSISSIPPI
 BOARD OF WATER COMMISSIONERS
 416 North State Street
 Jackson, Mississippi 39201

15F

WATER WELL DRILLERS LOG

9-17-1976 Bobby L. Swords Pontotoc
 date well completed firm name county well located

LANDOWNER: Charles I. Dillard
Rt. 2 Pontotoc, Miss
 (mailing address) 38841

description of formations encountered	from	to
<u>Red clay</u>	<u>0</u>	<u>25</u>
<u>Blue mud</u>	<u>25</u>	<u>300</u>
<u>Rock & Sand</u>	<u>300</u>	<u>345</u>

WELL LOCATION:
 sec. 8 T 8 N R 2 E
5 miles west of Eden
 (distance) (direction) (nearest town)

WELL PURPOSE: Home
 (home, irrigation, municipal, industrial)

- WELL COMPLETION DATA:
- (1) diameter (inches) 4"
 - (2) total depth (feet) 345
 - (3) static water level (feet) 30 below top of ground
 - (4) casing plastic, 95
 (material) (depth)
4" if telescope see back.
 (size)
 - (5) screen NONE
 (length) (depth to top)
 (size) (material)
 - (6) pump NONE
 (HP) (yield gpm)
 (type power)
 - (7) electric log _____
 (yes or no)
 (organization running log)
 - (8) how well bottom plugged Open


DRILLERS REMARKS:

RECEIVED
 OCT - 4 1976

MISS. BD. OF WATER COMM

If well telescopes please sketch and show depths.

GROUND LEVEL

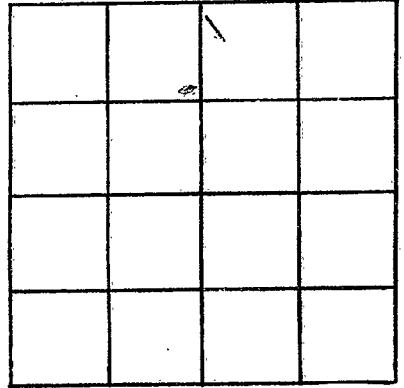

SECTION 33

Please indicate well location X.

ADDITIONAL INFORMATION

If more than one screen,
show locations of each on sketch.