

MISSISSIPPI
 BOARD OF WATER COMMISSIONERS
 416 North State Street
 Jackson, Mississippi 39201

for info

Oct 4-76
 Post Card Oct 22-76

PONTOTOC
 B 2000
 9/24/76

WATER WELL DRILLERS LOG

9-24 1976 Bibley L. Swords Pontotoc
 date well completed firm name county well located

LANDOWNER: Danny

description of formations encountered

from to

Swords

white clay

0 35

St. I Pontotoc Miss
 (mailing address)

Blue mud

35 245

Rock & Sand

245 285

WELL LOCATION:

sec 4 T 9 N R 2 E
 S W
8.3 miles SW of Ecru
 (distance) (direction) (nearest town)

WELL PURPOSE: Home
 (home, irrigation, municipal, industrial)

WELL COMPLETION DATA:

(1) diameter (inches) 4"

(2) total depth (feet) 285

(3) static water level (feet) 30 below above top of ground.

(4) casing PVC, 180
 (material) (depth)

4"
 (size) if telescope see back.

(5) screen NONE
 (length) (depth to top)

(size) (material)

(6) pump NONE
 (HP) (yield gpm)

(type power)

(7) electric log _____
 (yes or no)

(organization running log)

(8) how well bottom plugged Open


DRILLERS REMARKS:

RECEIVED
 OCT - 4 1976

MISS. Bd. OF WATER COMMISSIONERS

If well telescopes please sketch and show depths.

GROUND LEVEL

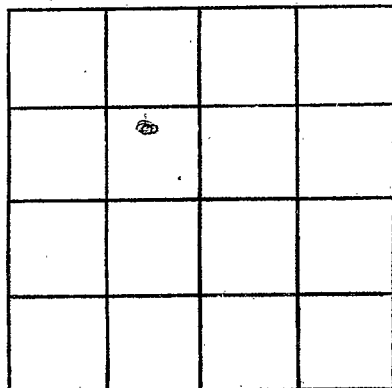

SECTION ~~PA~~ //

Please indicate well location X.

ADDITIONAL INFORMATION

If more than one screen,
show locations of each on sketch.