

**MISSISSIPPI
BOARD OF WATER COMMISSIONERS**
416 North State Street
Jackson, Mississippi 39201

WATER WELL DRILLERS LOG

PONTOTOC
B 2002
5-3-77

5-3 1977 Bobby L. Swords Pontotoc
date well completed firm name county well located

LANDOWNER: Jim Ross
Pontotoc, Miss.
Pt. 2
(mailing address)

description of formations encountered	from	to
<u>Red clay</u>	<u>0</u>	<u>20</u>
<u>Rock</u>	<u>30</u>	<u>60</u>
<u>Blue mud</u>	<u>60</u>	<u>170</u>
<u>Rock & sand</u>	<u>170</u>	<u>265</u>

WELL LOCATION:
sec. 21 T. 8 N R. 2 E
63 1/2 miles W of ECRU
(distance) (direction) (nearest town)

WELL PURPOSE: Home
(home, irrigation, municipal, industrial)

- WELL COMPLETION DATA:
- (1) diameter (inches) 4 1/2
 - (2) total depth (feet) 265
 - (3) static water level (feet) 30 below above top of ground.
 - (4) casing 8 ft.
(material) (depth)
4 1/2 if telescope see back.
(size)
 - (5) screen none
(length) (depth to top)
(size) (material)
 - (6) pump 1 1/2 Sage
(HP) (yield gpm)
Electric
(type power)
 - (7) electric log _____
(yes or no)
(organization running log)
 - (8) how well bottom plugged _____

DRILLERS REMARKS:


RECEIVED

JUN 16 1977

MISS. BD. OF WATER COMM.

If well telescopes please sketch and show depths.

GROUND LEVEL

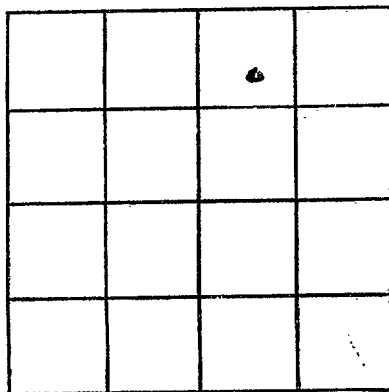

SECTION

21

Please indicate well location X.

ADDITIONAL INFORMATION

If more than one screen, show locations of each on sketch.