

PONTOTOC

B

2003

12-29-77

MISSISSIPPI BOARD OF WATER COMMISSIONERS  
416 North State Street  
Jackson, Mississippi 39201

WATER WELL DRILLERS LOG

*Pontotoc*

12-29 1977  
date well completed

*Leepus*  
firm name

county well located

LANDOWNER:

*Buchanan Baptist Church*  
*Pontotoc, Miss.*  
(mailing address)

description of formations encountered

from

to

<i>Jointed clay</i>	<i>0</i>	<i>20'</i>
<i>Red sand</i>	<i>20'</i>	<i>40'</i>
<i>Blue clay &amp; Rock</i>	<i>40'</i>	<i>160'</i>
<i>Chalk &amp; Rock</i>	<i>160'</i>	<i>300'</i>
<i>Sand</i>	<i>300'</i>	<i>350'</i>

WELL LOCATION:

sec. 11 T 9 N R 2 E  
*67* miles *West* of *Pontotoc*  
(distance) (direction) (nearest town)

WELL PURPOSE: *Home*  
(home, irrigation, municipal, industrial)

WELL COMPLETION DATA:

- (1) diameter (inches) 4
- (2) total depth (feet) 350
- (3) static water level (feet) 70 <sup>below</sup> top of ground.
- (4) casing Steel 84'  
(material) (depth)  
(size) if telescope see back.
- (5) screen \_\_\_\_\_  
(length) (depth to top)  
(size) (material)
- (6) pump 1 HP 10  
(HP) (yield gpm)  
Electric  
(type power)
- (7) electric log No  
(yes or no)

(organization running log)

(8) how well bottom plugged open

DRILLERS REMARKS:


RECEIVED

APR 24 1978

MISS. BD. OF WATER COMMISSIONERS

If well telescopes please sketch and show depths.

GROUND LEVEL

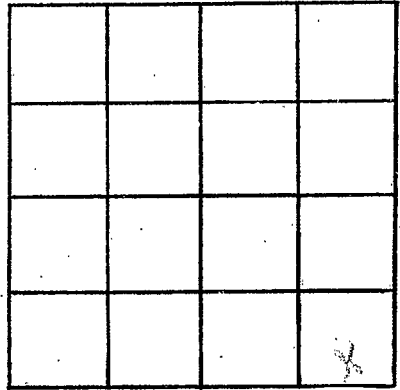

SECTION 11

Please indicate well location X.

ADDITIONAL INFORMATION

If more than one screen, show locations of each on sketch.