

PONTOTOC
 B *2004*
 4-6-78

MISSISSIPPI
 BOARD OF WATER COMMISSIONERS
 416 North State Street
 Jackson, Mississippi 39201

WATER WELL DRILLERS LOG

4-6 1978 *Leaper* *Pontotoc*
 date well completed firm name county well located

LANDOWNER:
David Hillard
Rt. 7 Pontotoc
 (mailing address)

WELL LOCATION:
 sec. *25* T. *28* N. R. *2* E
3.7 miles *NW* of *Coan*
 (distance) (direction) (nearest town)

WELL PURPOSE: *Home*
 (home, irrigation, municipal, industrial)

WELL COMPLETION DATA:

(1) diameter (inches) *4*

(2) total depth (feet) *160*

(3) static water level (feet) *60* ^{below} _{above} top of ground.

(4) casing *Steel*, *84*,
 (material) (depth)
 (size) if telescope see back.

(5) screen *open*
 (length) (depth to top)
 (size) (material)

(6) pump *3/4 HP* *10*
 (HP) (yield gpm)
Elec
 (type power)

(7) electric log *No*
 (yes or no)
 (organization running log)

(8) how well bottom plugged *open*

description of formations encountered	from	to
<i>Pontotoc sand</i>	<i>0</i>	<i>15</i>
<i>Red clay</i>	<i>15</i>	<i>20</i>
<i>Red clay + mid sand</i>	<i>20</i>	<i>160</i>
<i>Blue clay</i>	<i>160</i>	<i>170</i>
<i>Shaded sand</i>	<i>160</i>	<i>160</i>
<i>Water + sand</i>	<i>160</i>	<i>160</i>


DRILLERS REMARKS:

RECEIVED
 APR 27 1978

MISS. Bd. OF WATER COMM

If well telescopes please sketch and show depths.

GROUND LEVEL

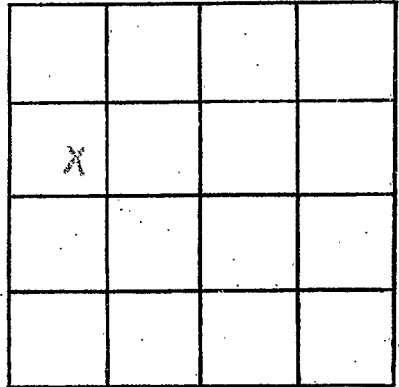

SECTION 25

Please indicate well location X.

ADDITIONAL INFORMATION

Lined area for additional information.

If more than one screen, show locations of each on sketch.