

Pontotoc

B 2007

8/80

Aug 1980

date well completed

MISSISSIPPI  
 BOARD OF WATER COMMISSIONERS  
 416 North State Street  
 Jackson, Mississippi 39201

WATER WELL DRILLERS LOG

LEEPER

firm name

Pontotoc

county well located

LANDOWNER:

Calvin Ruykendall  
 Co West Pontotoc MS  
 (mailing address)

description of formations encountered

from to

Top clay	0	30
Blue clay	30	200
Chalk	200	300
Sand	300	350

WELL LOCATION:

sec. 32 T 9 N R 20 E  
 S W

(distance) miles of (direction) (nearest town)

WELL PURPOSE: Home  
 (home, irrigation, municipal, industrial)

WELL COMPLETION DATA:


- (1) diameter (inches) 4"
- (2) total depth (feet) 350
- (3) static water level (feet) 90 below top of ground.
- (4) casing PVC 140 (material) (depth)
- (size) If telescope see back.
- (5) screen Non (length) (depth to top)
- (size) (material)
- (6) pump 1/2 10 (HP) (yield gpm)
- 5 hp (type power)
- (7) electric log NO (yes or no)
- (organization running log)
- (8) how well bottom plugged OPEN

DRILLERS REMARKS:

DEPT. OF NATURAL RESOURCES  
 BUREAU OF LAND & WATER RESOURCES


FEB 24 1981

RECEIVED

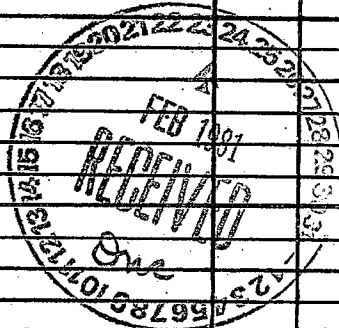

If well telescopes please sketch and show depths.

GROUND LEVEL

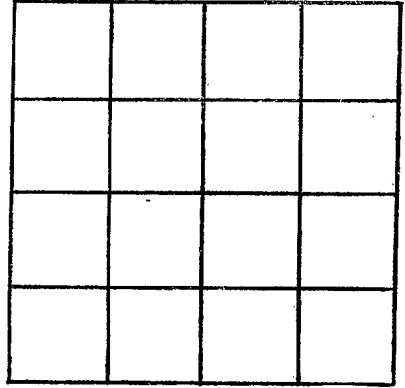

SECTION \_\_\_\_\_

Please indicate well location X.

ADDITIONAL INFORMATION

If more than one screen,  
show locations of each on sketch.