

MISSISSIPPI DEPARTMENT OF NATURAL RESOURCES

Bureau of Land and Water Resources

Southport Mall

P.O. Box 10631

Jackson, Mississippi 39209

4

WATER WELL DRILLERS LOG

Pontotoc
B 2008
8-6-80

Aug 6 1980 LEEPER Drilling Pontotoc
 date well completed firm name county well located

LANDOWNER:	description of formations encountered	from	to
<u>Calvin Kuykendall</u> <u>6 West Pontotoc</u> (mailing address)			
WELL LOCATION: sec. <u>31</u> T <u>9</u> N R <u>2</u> E S W <u>7</u> miles <u>W</u> of <u>Pontotoc</u> (distance) (direction) (nearest town)	<u>Blue clay</u>	<u>20</u>	<u>250</u>
WELL PURPOSE: <u>Home</u> (home, irrigation, municipal, industrial)	<u>Chalk</u>	<u>250</u>	<u>380</u>
WELL COMPLETION DATA: (1) diameter (inches) <u>4</u> (2) total depth (feet) <u>410</u> (3) static water level (feet) <u>70</u> below above top of ground. (4) casing <u>PVC</u> <u>390</u> (material) (depth) <u>4</u> if telescope see back. (size) (5) screen <u>20</u> <u>390</u> (length) (depth to top) <u>4</u> <u>PVC</u> (size) (material) (6) pump <u>3/4</u> <u>10</u> (HP) (yield gpm) <u>electric</u> (type power) (7) electric log <u>(yes of no)</u> (organization running log) (8) how well bottom plugged <u>CAP</u>	<u>Sand</u>	<u>380</u>	<u>410</u>

DEPT. OF NATURAL RESOURCES
 BUREAU OF LAND & WATER RESOURCES


SEP 17 1981

RECEIVED

DRILLERS REMARKS:

If well telescopes please
sketch and show depths.

GROUND LEVEL

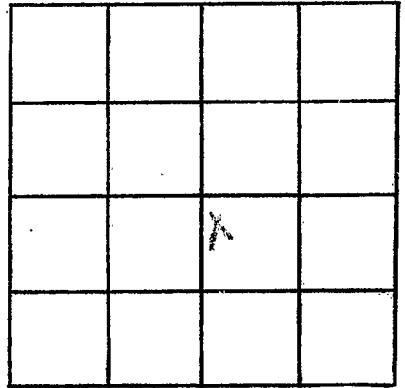

SECTION

31

Please indicate well location X.

ADDITIONAL INFORMATION

If more than one screen,
show locations of each on sketch.