

**MISSISSIPPI
BOARD OF WATER COMMISSIONERS**
416 North State Street
Jackson, Mississippi 39201

WATER WELL DRILLERS LOG

PONTOTOC
B 2009

date well completed 11/12/85 firm name LEEPER Drilling county well located PONTOTOC

LANDOWNER: PAUL WARREN
Hiway 6 West
PONTOTOC MS
(mailing address)

WELL LOCATION:
sec. 19 T. 9 N R. 2 E
6 miles W of PONTOTOC
(distance) (direction) (nearest town)

WELL PURPOSE: Home
(home, irrigation, municipal, industrial)

WELL COMPLETION DATA:

- (1) diameter (inches) 4"
- (2) total depth (feet) 300 ft
- (3) static water level (feet) 70 below above top of ground.
- (4) casing PVC 198
(material) (depth)
4" if telescope see back.
(size)
- (5) screen NONE
(length) (depth to top)
(size) (material)
- (6) pump 1 10
(HP) (yield gpm)
Elec
(type power)
- (7) electric log NO
(yes or no)
(organization running log)
- (8) how well bottom plugged OPEN

description of formations encountered	from	to
<u>TOP clay</u>	<u>0</u>	<u>20</u>
<u>Blue clay</u>	<u>20</u>	<u>180</u>
<u>CHALK</u>	<u>180</u>	<u>300</u>
<u>SAND</u>	<u>300</u>	<u>300</u>


DRILLERS REMARKS: _____

RECEIVED
NOV 20 1985

Department of Natural Resources
Bureau of Land & Water Resources

If well telescopes please sketch and show depths.

GROUND LEVEL

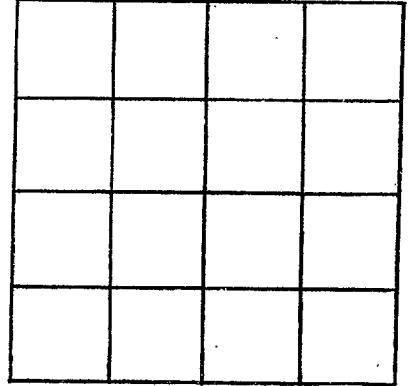

SECTION _____

Please indicate well location X.

ADDITIONAL INFORMATION

If more than one screen, show locations of each on sketch.